

SEC. 10, T.4S, R.1E, W.M.

N

4-2" LATERALS BURIED
40' APART

S. E. 1/4
S. E. 1/4
1.93 Ac.

WELL

710'
WEST


10 11
325'
NORTH
15 14

2" MAIN
HEADER
BURIED

T.L. 2500

T.L. 200

SCALE-1"=400'

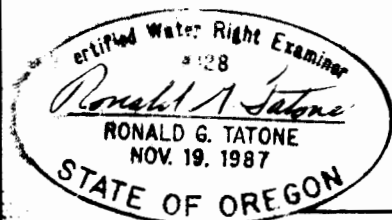

KRAXBERGER RD.

FINAL PROOF SURVEY

APPLICATION NO. G-12667
PERMIT NO. G-11461

KERMITT M. MILLER

NOTE:

9709 KRAXBERGER RD.

THIS MAP IS FOR THE PURPOSE OF IDENTIFYING
THE LOCATION OF THE WATER RIGHT ONLY AND
IS NOT INTENDED TO PROVIDE LEGAL DIMENSIONS
OR LOCATION OF PROPERTY OWNERSHIP LINES.

HARMES RD.

RECEIVED

JUL 25 1996

WATER RESOURCES DEPT
SALEM, OREGON

ZTec ENGINEERS, INC.

3737 S.E. 8TH AVE., PORTLAND, OR. 97202
PHONE: (503) 235-8795
FAX: (503) 233-7889