

Legend

- Structure
- ▨ Irrigation Area
- POD
- - - - Pipeline
- · - · - Stream
- - - - Line
- Flow\_arrow
- Township
- DLC
- Section
- - - - Quarter
- - - - Sixteenth
- Parcels

# CLAIM OF BENEFICIAL USE MAP

FOR: JOHN PROCTOR  
 BY: NATHAN R. REED, CWRE  
 T26S, R4W, W.M. SECTION 13 DLC 39  
 APPLICATION NO. S-87601  
 PERMIT NO. S-54745




DATE SURVEYED: AUGUST 7, 2012

RECEIVED BY OWRD  
 RECEIVED BY OWRD  
 OCT 03 2012  
 SALEM, OR



POD IS LOCATED 2487 FEET WEST AND 87 FEET NORTH  
 OF THE CENTER 1/4 CORNER OF SECTION 13.

MAP PREPARED FOR:  
 JOHN PROCTOR  
 P.O. BOX 1760  
 ROSEBURG, OR 97470

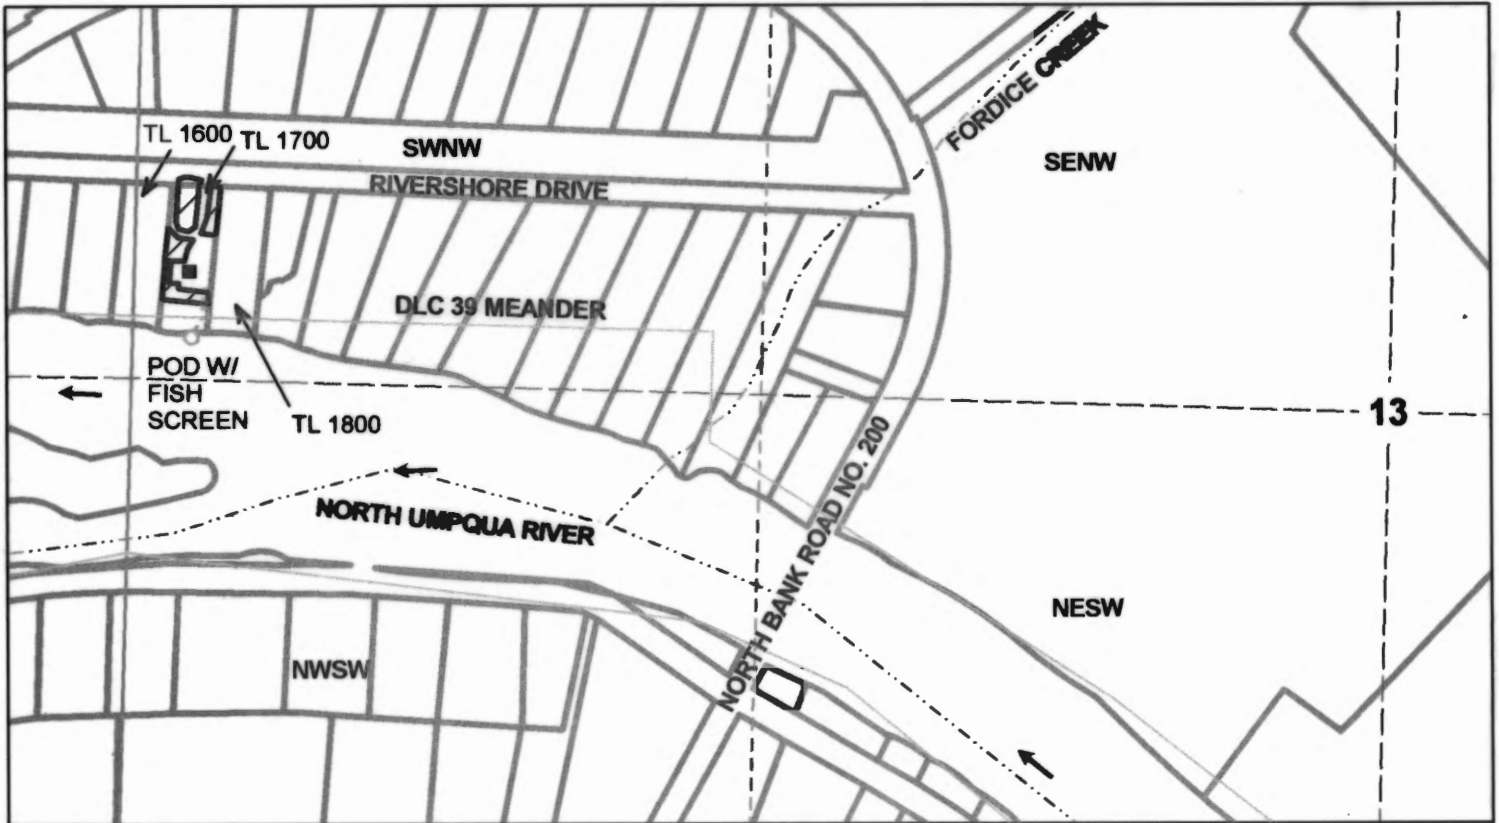

THE PURPOSE OF THIS MAP IS TO IDENTIFY THE LOCATION OF THE WATER RIGHT. IT IS NOT INTENDED TO PROVIDE INFORMATION RELATIVE TO THE LOCATION OF PROPERTY OWNERSHIP BOUNDARY LINES.

MAP PREPARED BY:  
 NATHAN R. REED, P.E., CWRE  
 1113 SE CASS AV  
 ROSEBURG, OR 97470