


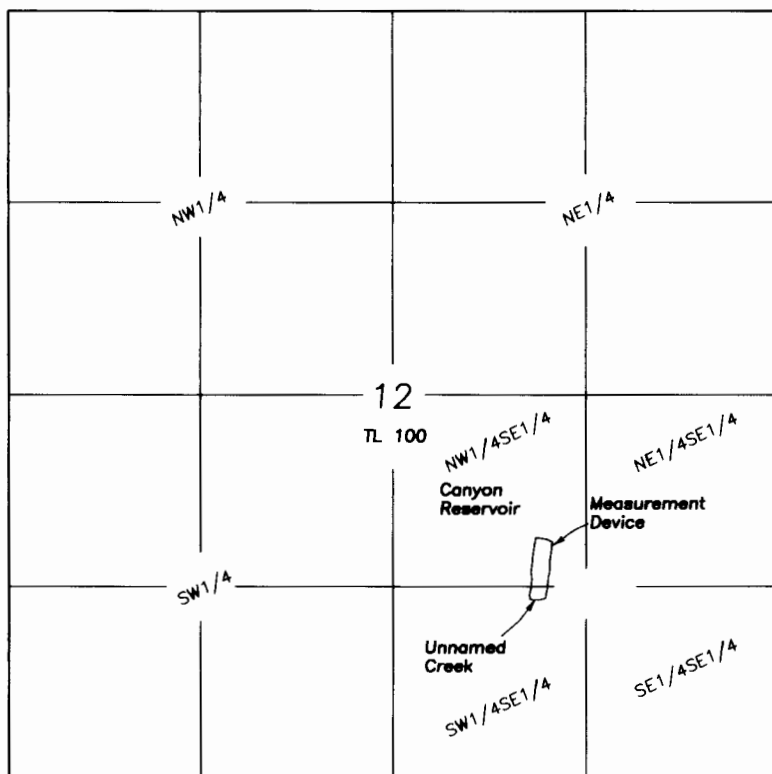

SCALE 1"=1320'

Measuring device is located 10' North of the Outlet.

FINAL PROOF SURVEY
CLAIM OF BENEFICIAL USE
CANYON RESERVOIR

For

Bureau of Land Management

November 9, 2016

LEGEND

Application No. R-59662
Permit No. R-8094
Priority 12/21/1979

A portion of Tax Lot
28-27 TL100

NOTE: Tax Lot 100 is owned by the BLM and is more that 23,000 acres. No boundaries of the tax lot can be shown.

Prepared by
Cornerstone Surveying, Inc

P.O. BOX 33
JOHN DAY, OR. 97845
(541)575-1813

cornerstonesurvey@centurytel.net

NOTE: The preparation of this map was for the purpose of identifying the location of the proposed water right and has no intent to provide dimensions or location of property ownership lines.

RECEIVED BY OWRC

FEB 06

SALEM, OH

