


RECEIVED
SEP 10 2004
WATER RESOURCES DEPT
SALEM, OREGON

RECEIVED
AUG 27 2004
WATER RESOURCES DEPT
SALEM, OREGON

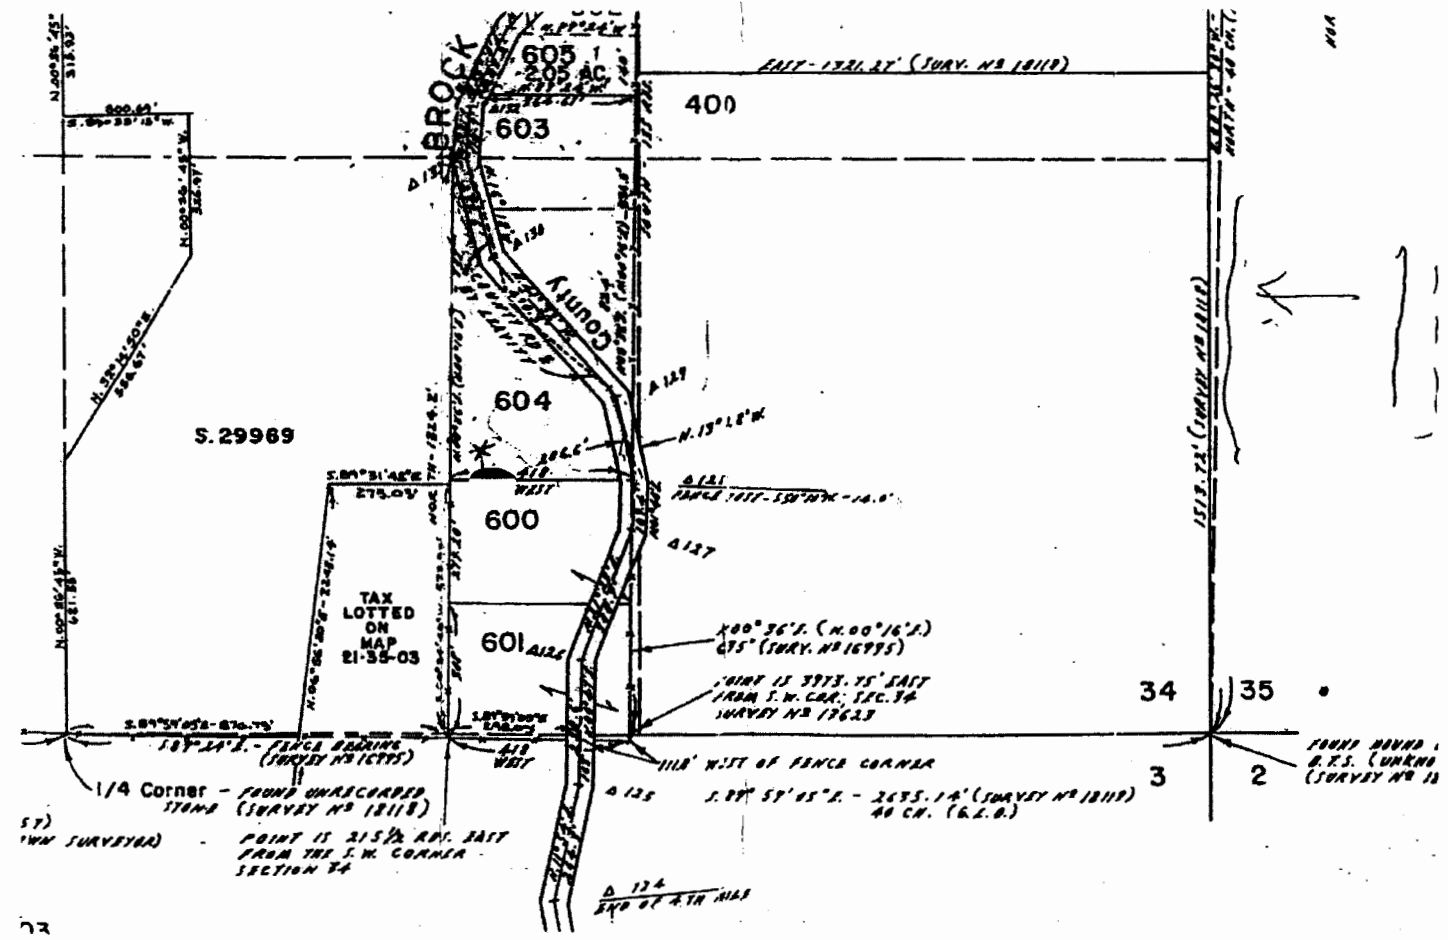

* = Pond
1 inch = 400 feet

TOWNSHIP (N or S)	RANGE (E or W)	Section	Quarter/Quarter
20	3E	34	SW, SE
			Tax lot #
			00604

610 feet North
Pond is ~~4500~~ East and ~~215~~ West
of SE corner Section 34

map revised by OWRD to show
correct measured distance.

CE/WAD 2/23/17

RECEIVED BY OWRD

JUL 21 2016

SALEM, OR

R-86101