

702


LEGEND

-  PRIMARY IRRIGATION PER PERMIT S-72390 AND SUPPLEMENTAL IRRIGATION PER TRANSFER T-6728
-  PROPERTY BOUNDARY LINE
-  TAX LOT LINE
-  1/16TH SECTION
-  EXISTING WATER MAIN PIPES
-  HYDRANT
-  RESTROOM

CLAIM OF BENEFICIAL USE MAP

SECTIONS 11 & 12, T2N, R3W, WM
LOTS 100 & 200 OF TAX MAP 2N 3W 11 &
LOT 300 OF TAX MAP 2N 3W 12
WASHINGTON COUNTY, OREGON
TRANSFER T-6728
APPLICATION R-72389 / PERMIT R-13789
APPLICATION S-72390 / PERMIT S-53992

PREPARED FOR:
ROBERT D. HORNING AND
JANE A. HORNING
21277 NW BRUNSWICK CANYON RD.
NORTH PLAINS, OREGON 97133

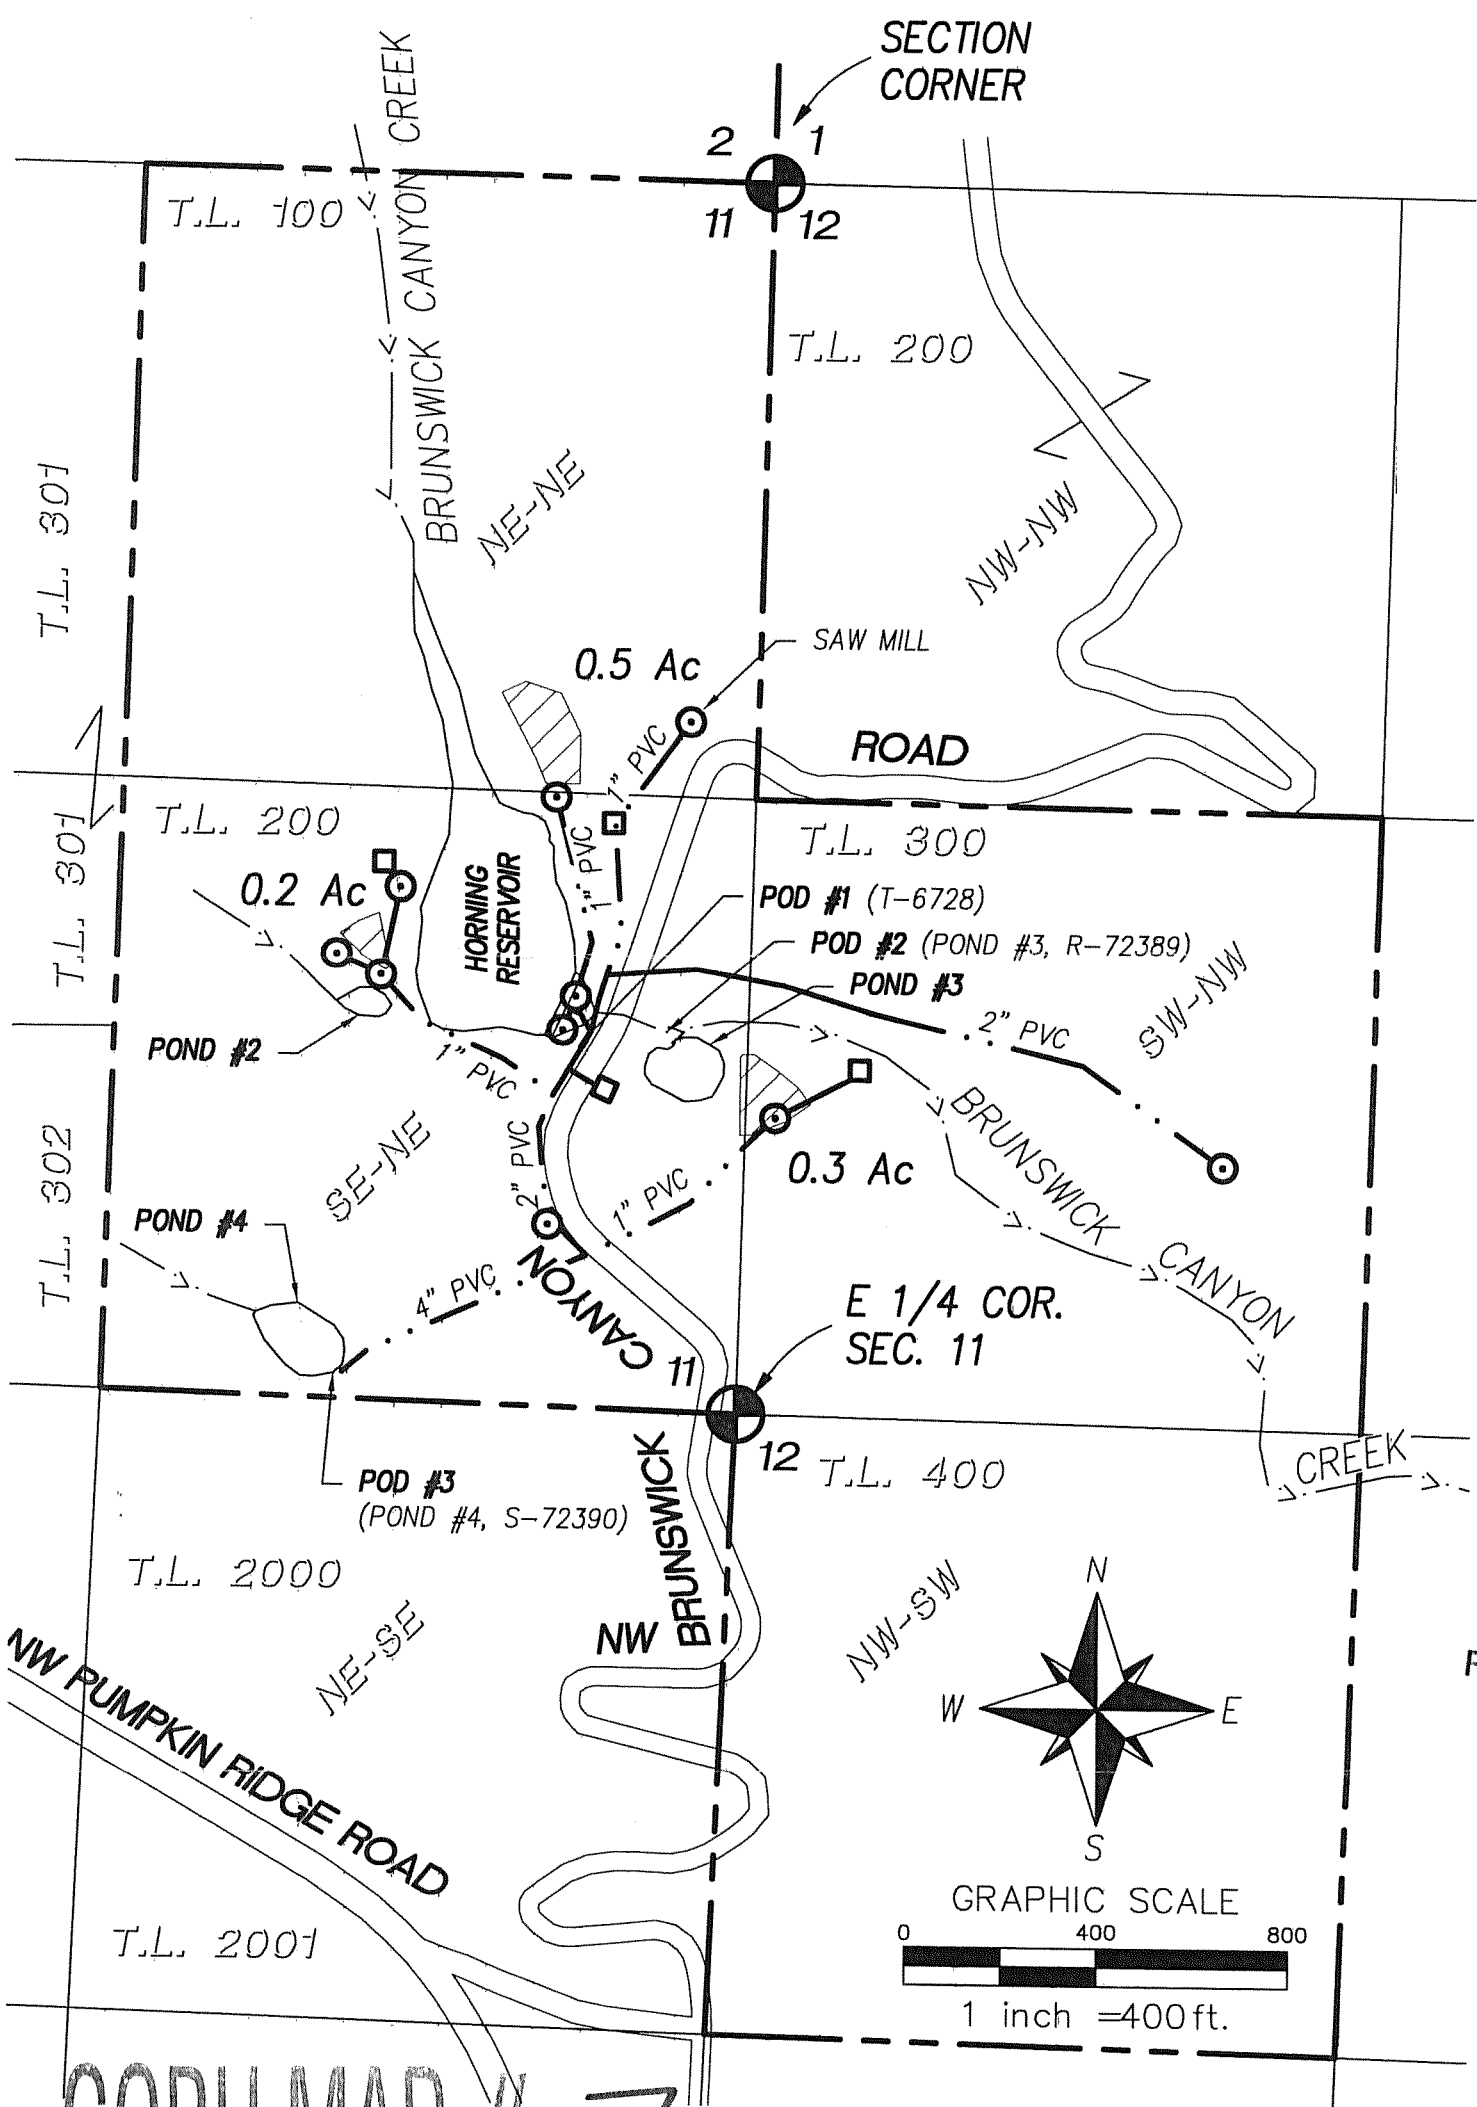

RESERVOIR AND POD LOCATIONS

FROM E 1/4 CORNER OF SECTION 11

HORNING RESERVOIR
860' NORTH 370' WEST

POND #2
860' NORTH 720' WEST



POND #3
780' NORTH 60' WEST

POND #4
80' NORTH 840' WEST

POD #1
770' NORTH 330' WEST

POD #2
800' NORTH 150' WEST

POD #3
80' NORTH 840' WEST

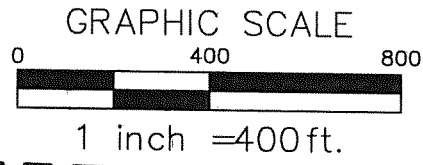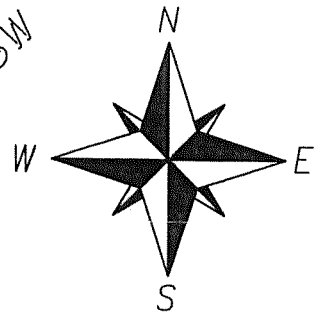

RECEIVED BY OWRD
SEP 07 2012
SALEM, OR

COBU MAP # 702 folder V

MAP BASES: WASHINGTON COUNTY TAX MAPS 2N 3W SEC. 11 AND 2N 3W SEC. 12
2011 AERIAL PHOTO FROM GOOGLE EARTH

THIS MAP WAS PREPARED FOR THE PURPOSE OF IDENTIFYING THE LOCATION OF A WATER RIGHT ONLY AND IS NOT INTENDED TO PROVIDE LEGAL DIMENSIONS OR LOCATION OF PROPERTY OWNERSHIP LINES.

Certified Water Right Examiner
59859
Kaid E. McKay
KAID EDWARD MCKAY
MAY 21, 2010
STATE OF OREGON
EXPIRES: 12-31-2012

Stuntzner
Engineering & Forestry, LLC
* COOS BAY * DALLAS *
* FOREST GROVE *
Project: 310-2-026
By: Kaid E. McKay
Date: August 5, 2012