


CLAIM OF BENEFICIAL USE MAP
FOR KEITH W. DOTTER
LOCATED IN THE NW1/4 OF THE SW1/4 OF SECTION 21,
TOWNSHIP 23 SOUTH, RANGE 12 WEST, W.M.,
COOS COUNTY, OREGON

APPLICATION #S-80881
PERMIT #53200

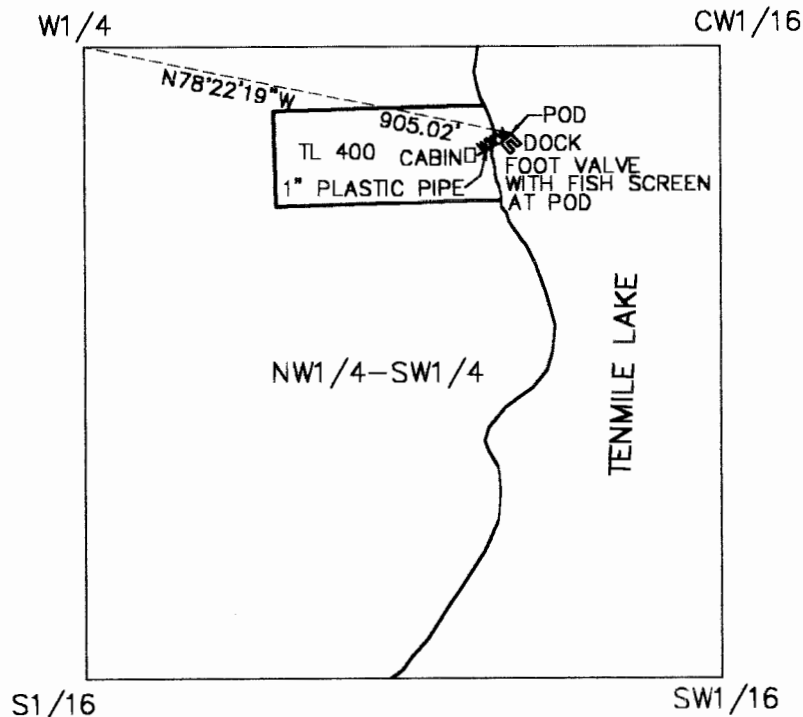

SCALE 1" = 400'

RECEIVED BY OWRD


AUG 23 2012


SALEM, OR

LEGEND:

POD POINT OF DIVERSION

TL TAX LOT

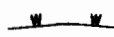 WATER PIPE LINE

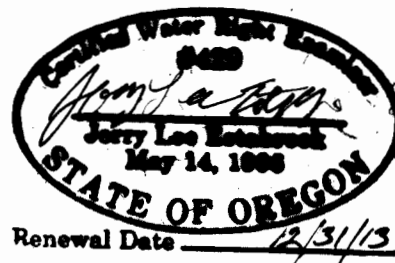

EXAMINERS DISCLAIMER STATEMENT:
THE PREPARATION OF THIS MAP WAS FOR THE PURPOSE OF
IDENTIFYING THE LOCATION OF WATER RIGHT ONLY AND HAS
NO INTENT TO PROVIDE DIMENSIONS OR LOCATION OF
PROPERTY OWNERSHIP LINES.