

APPLICATION MAP FOR A CLAIM OF BENEFICIAL USE


Application S-74495 Permit 52450

IN THE NAME OF: JAMES B. AND PENNY A. HUMBERT

PLACE OF USE LOCATED IN THE SE 1/4, NW 1/4, SECTION 19

TOWNSHIP 31 SOUTH, RANGE 11 WEST OF THE WILLAMETTE MERIDIAN. TAX LOT 400

13
18
24 19

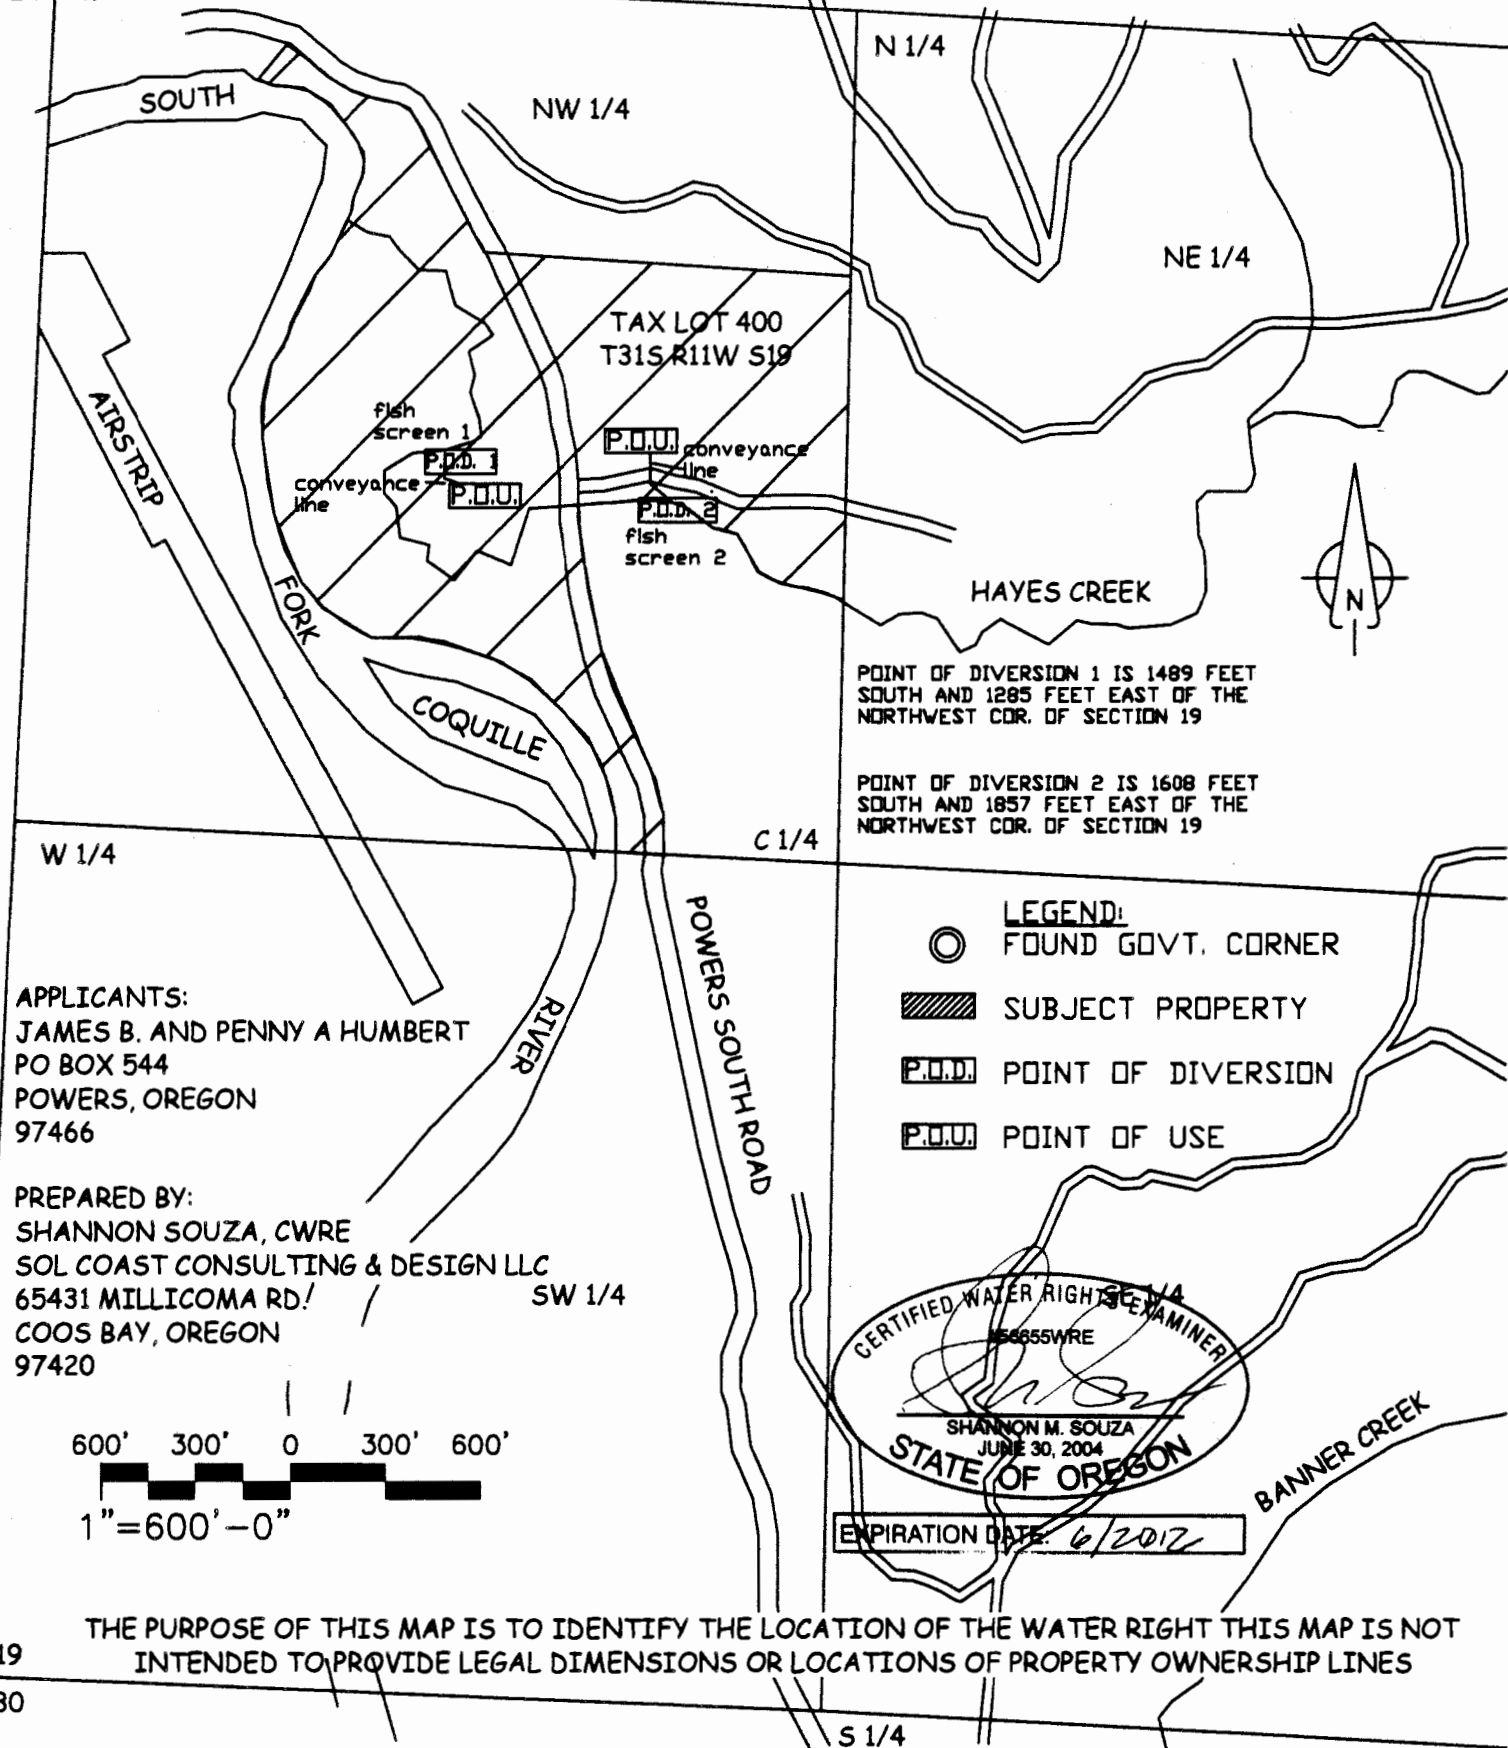

APPLICANTS:
JAMES B. AND PENNY A HUMBERT
PO BOX 544
POWERS, OREGON
97466

PREPARED BY:
SHANNON SOUZA, CWRE
SOL COAST CONSULTING & DESIGN LLC
65431 MILLICOMA RD.
COOS BAY, OREGON
97420

600' 300' 0 300' 600'
1"=600'-0"

LEGEND:
○ FOUND GOVT. CORNER
▨ SUBJECT PROPERTY
P.O.D. POINT OF DIVERSION
P.O.U. POINT OF USE

CERTIFIED WATER RIGHT EXAMINER
56655WRE
SHANNON M. SOUZA
JUNE 30, 2004
STATE OF OREGON
EXPIRATION DATE: 6/2012

THE PURPOSE OF THIS MAP IS TO IDENTIFY THE LOCATION OF THE WATER RIGHT THIS MAP IS NOT INTENDED TO PROVIDE LEGAL DIMENSIONS OR LOCATIONS OF PROPERTY OWNERSHIP LINES