


T. 5 N. R. 30 E. W. M.

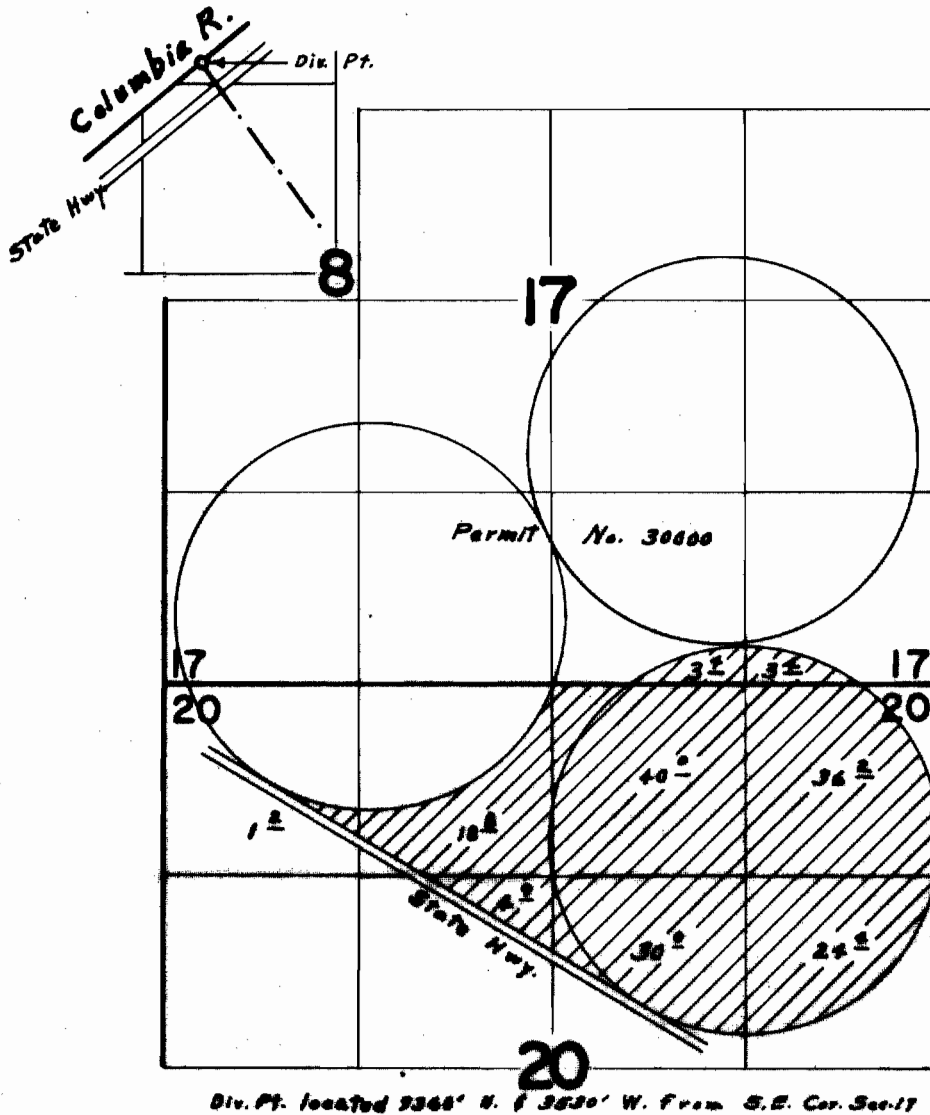

FINAL PROOF SURVEY
UNDER

Application No. 45719 Permit No. 33594
IN NAME OF

ERVIN R. EDMUNDS

Surveyed Sept. 2, 1971, by L. E. Gould