


EXHIBIT B

T29S, R30E, W.M.
Harney County, Oregon

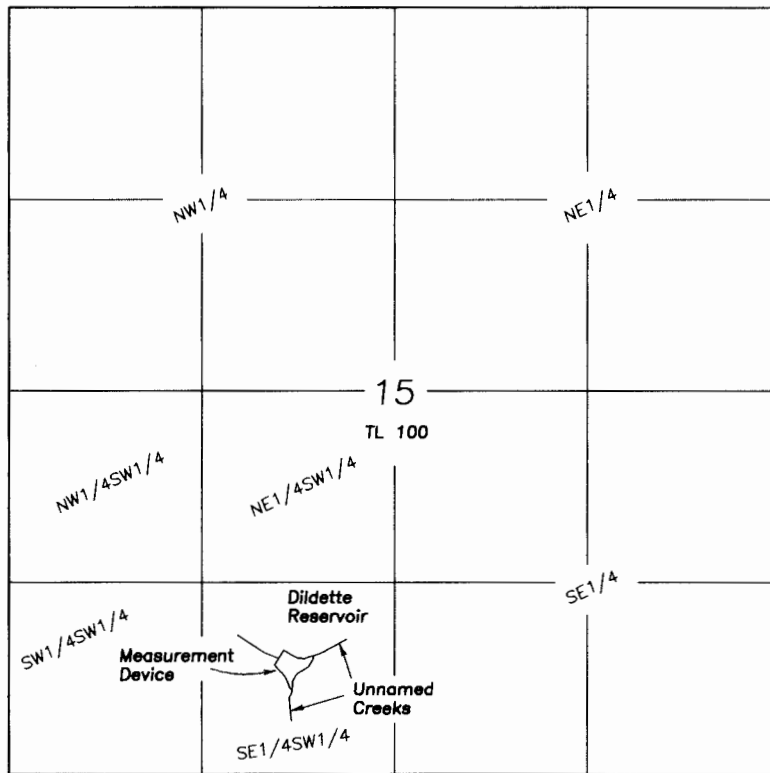

SCALE 1"=1320'

Outlet is located 710' North & 1860' East of the
SW corner of Section 15.

Measuring device is located 18' North & 52' West of the Outlet.

FINAL PROOF SURVEY
CLAIM OF BENEFICIAL USE
DILDETTE RESERVOIR

For

Bureau of Land Management

January 24, 2017

LEGEND

Application No. R-59654

Permit No. R-8086

Priority 12/21/1979

A portion of Tax Lot
29-30 TL100

NOTE: Tax Lot 100 is owned by the BLM
and is more that 22,000 acres.
No boundaries of the tax lot
can be shown.

NOTE: The preparation of this map
was for the purpose of identifying
the location of the proposed water
right and has no intent to provide
dimensions or location of property
ownership lines.

RECEIVED BY OWRD

JAN 26 2017

SALEM, OR

Prepared by
Cornerstone Surveying, Inc

P.O. BOX 33
JOHN DAY, OR. 97845

(541)575-1813

cornerstonesurvey@centurytel.net

