

T 20 S, R 3 W Sec 14
NE 1/4, NW 1/4

TAX MAP LOT 20 03 11 00 00 500
& 503

pond outlet is 130 ft. south
and 2,330 ft West from
SE cor DLC 48 in sec. 11

Travis Harrold



RECEIVED BY OWRD


JUN 09 2015

SALEM, OR

SALEM, OR

JUL 15 2016

RECEIVED BY OWRD

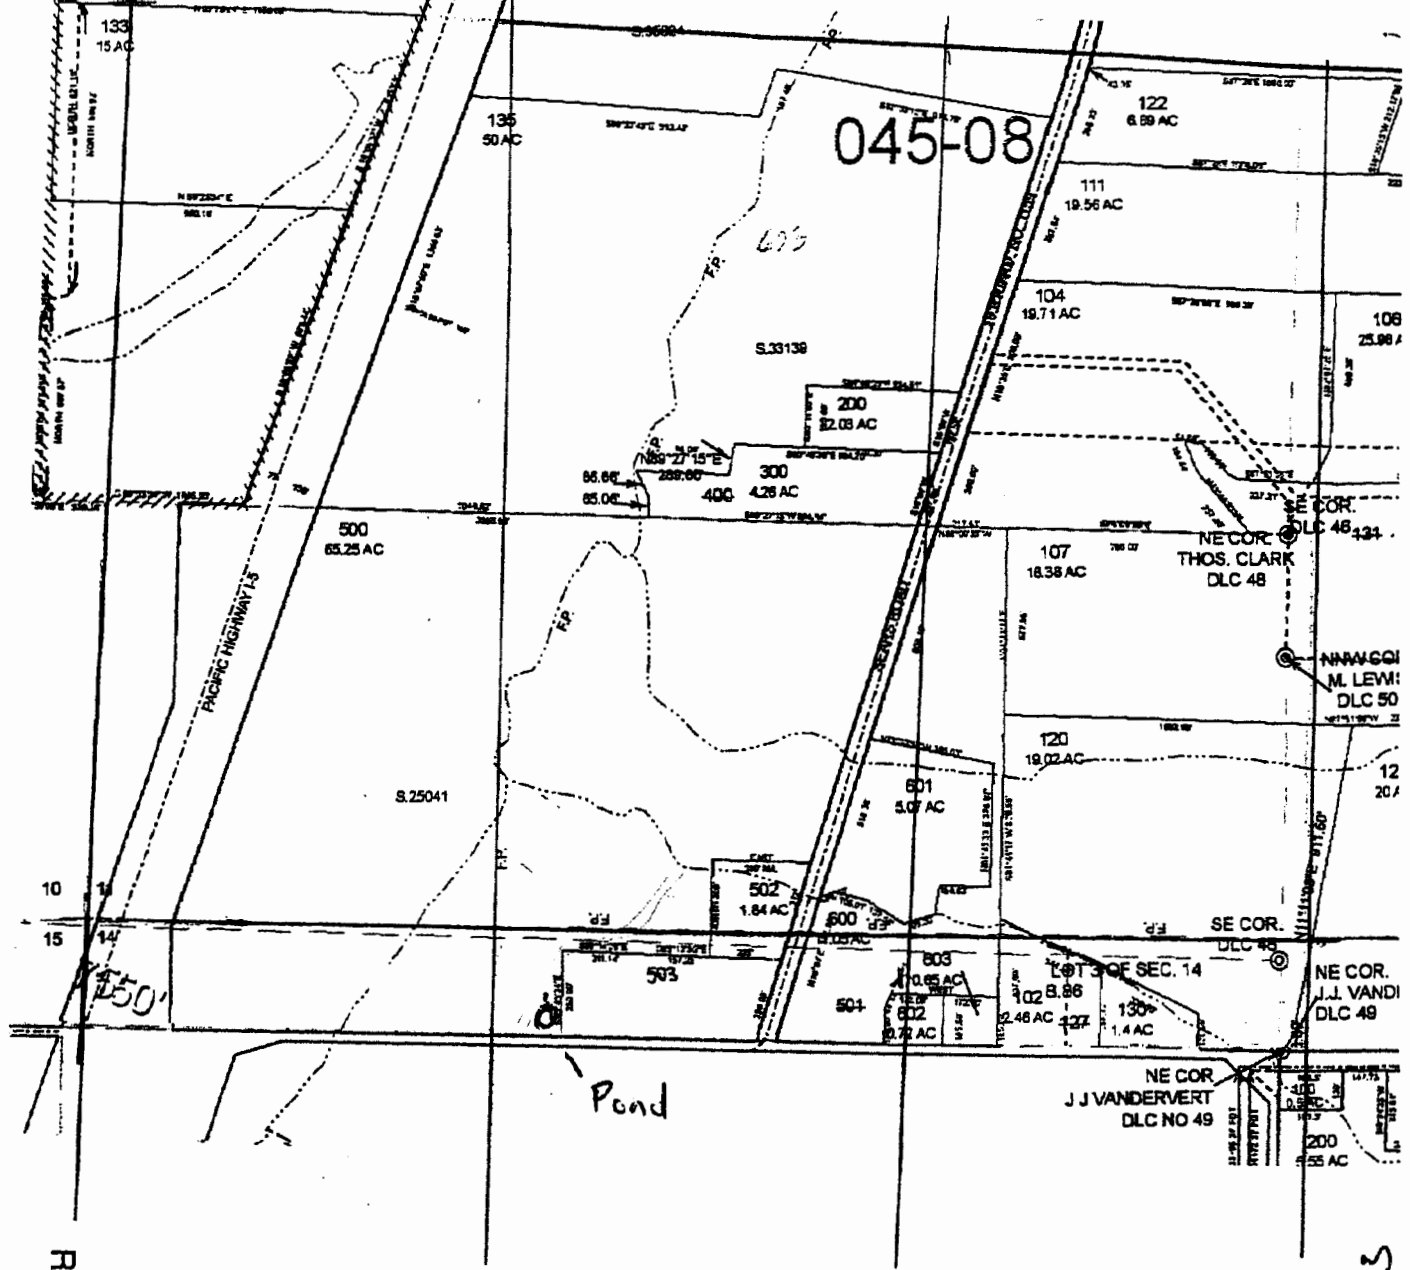

R-151-1

Reels