


MAP TO ACCOMPANY CLAIM OF BENEFICIAL USE
CHANGE IN POINT OF DIVERSION

FOR

Richard K. Defreez & Toni J. Kristensen

T.33S. R.5W. W.M.

TRANSFER T 9755

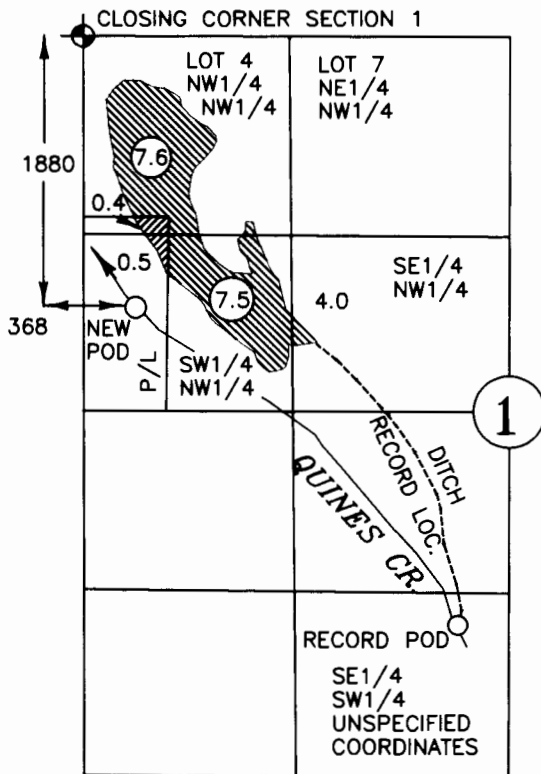

POD SURVEY TIED TO
NE PROPERTY CORNER
AND CALCULATED TO
CLOSING CORNER SECTION
1 FROM SURVEY M142-66
AND LP 1993-0078
OF DOUGLAS COUNTY
SURVEY RECORDS.



AREA THIS
TRANSFER




AREA NOT
INCLUDED IN
THIS TRANSFER
CERT. # 81185



SCALE 1"=1320

THIS MAP TO BE USED
FOR WATER RIGHT
PURPOSES ONLY

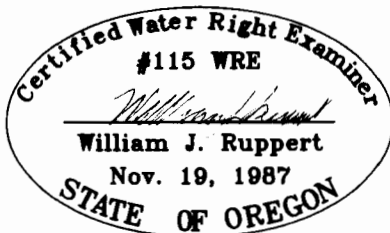

EXPIRES 12-31-06

BY : WILLIAM J. RUPPERT
P.O. BOX 1564
MYRTLE CREEK, OR 97457

JUNE 18, 2005