


RECEIVED

OCT 22 2012

WATER RESOURCES DEPT  
SALEM, OREGON

**T.6S., R.5W., W.M.**  
Polk County

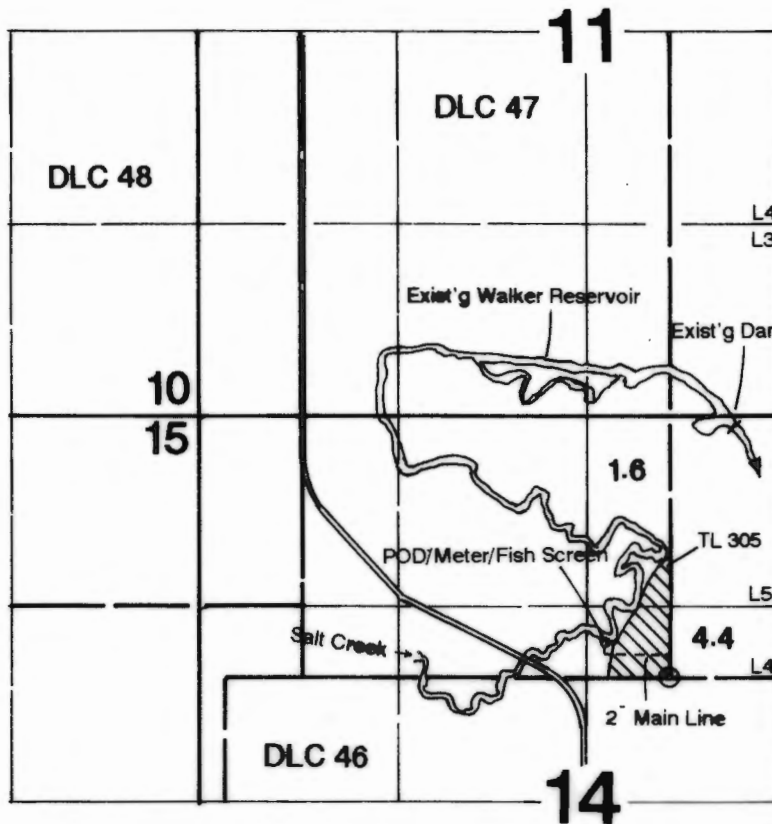

POD is located 235'N & 452'W from the SE corner of DLC 47.

**Final Proof Survey**


In the Name of

**Dan Van Otten**

Application #: S-87270      Permit #: S-54505

Surveyed on September 22, 2012 by JM Schuette

This Map was Prepared for the Purpose of Identifying the Location of a Water Right Only and is Not Intended to Provide Legal Dimensions or Location of Property Ownership Lines.

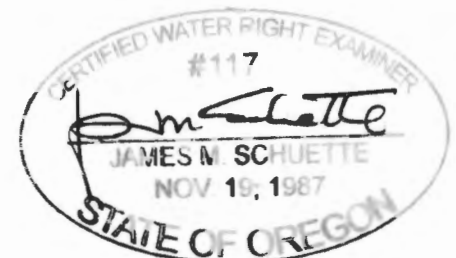

EXPIRES 6/30/2014