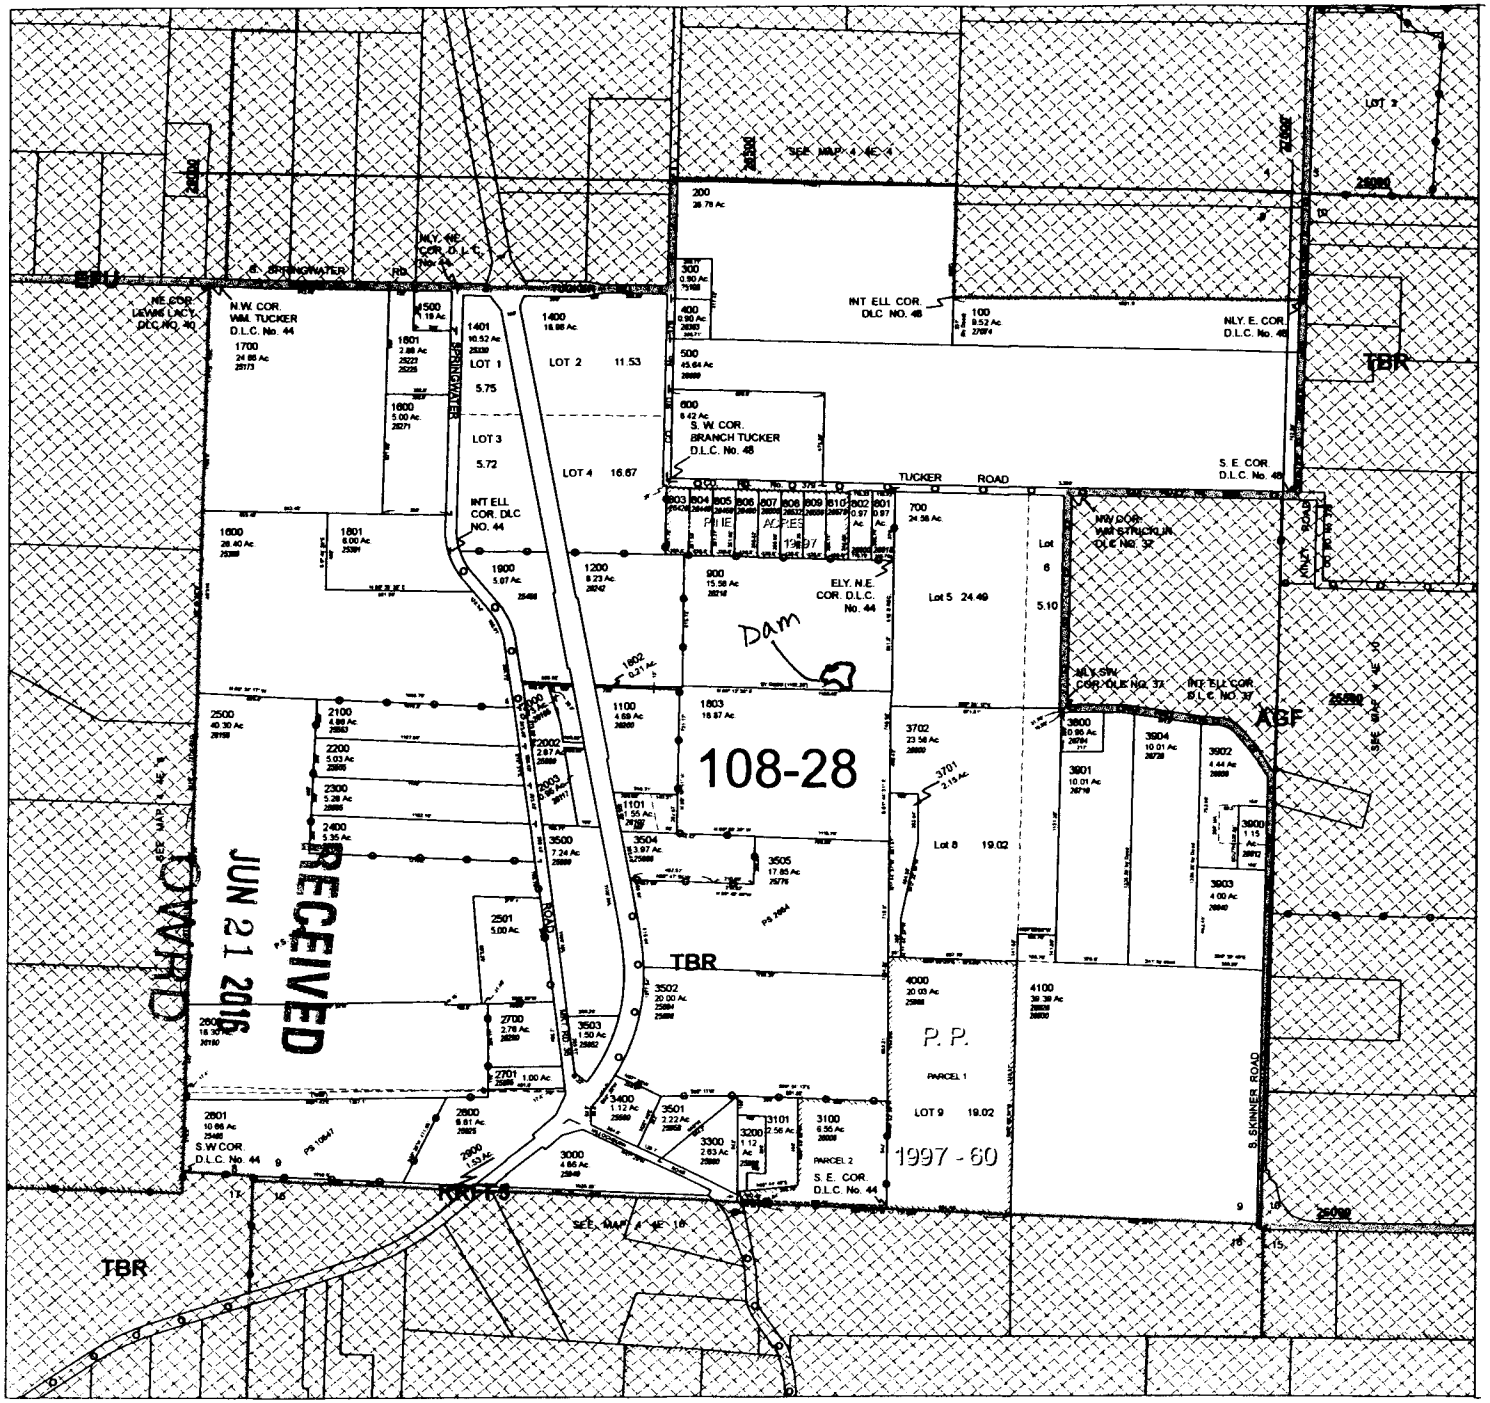


4S/4E-9

1" = 1000'

Dam located:
2370' W
2600' S
from NE corner S. 9

COBU map