

RECEIVED BY OWRD


JUL 11 2016

SALEM, OR

WORK
COPY

SEE M

Note: For Survey of
all but the SW 1/4
See C.S. 123-71.

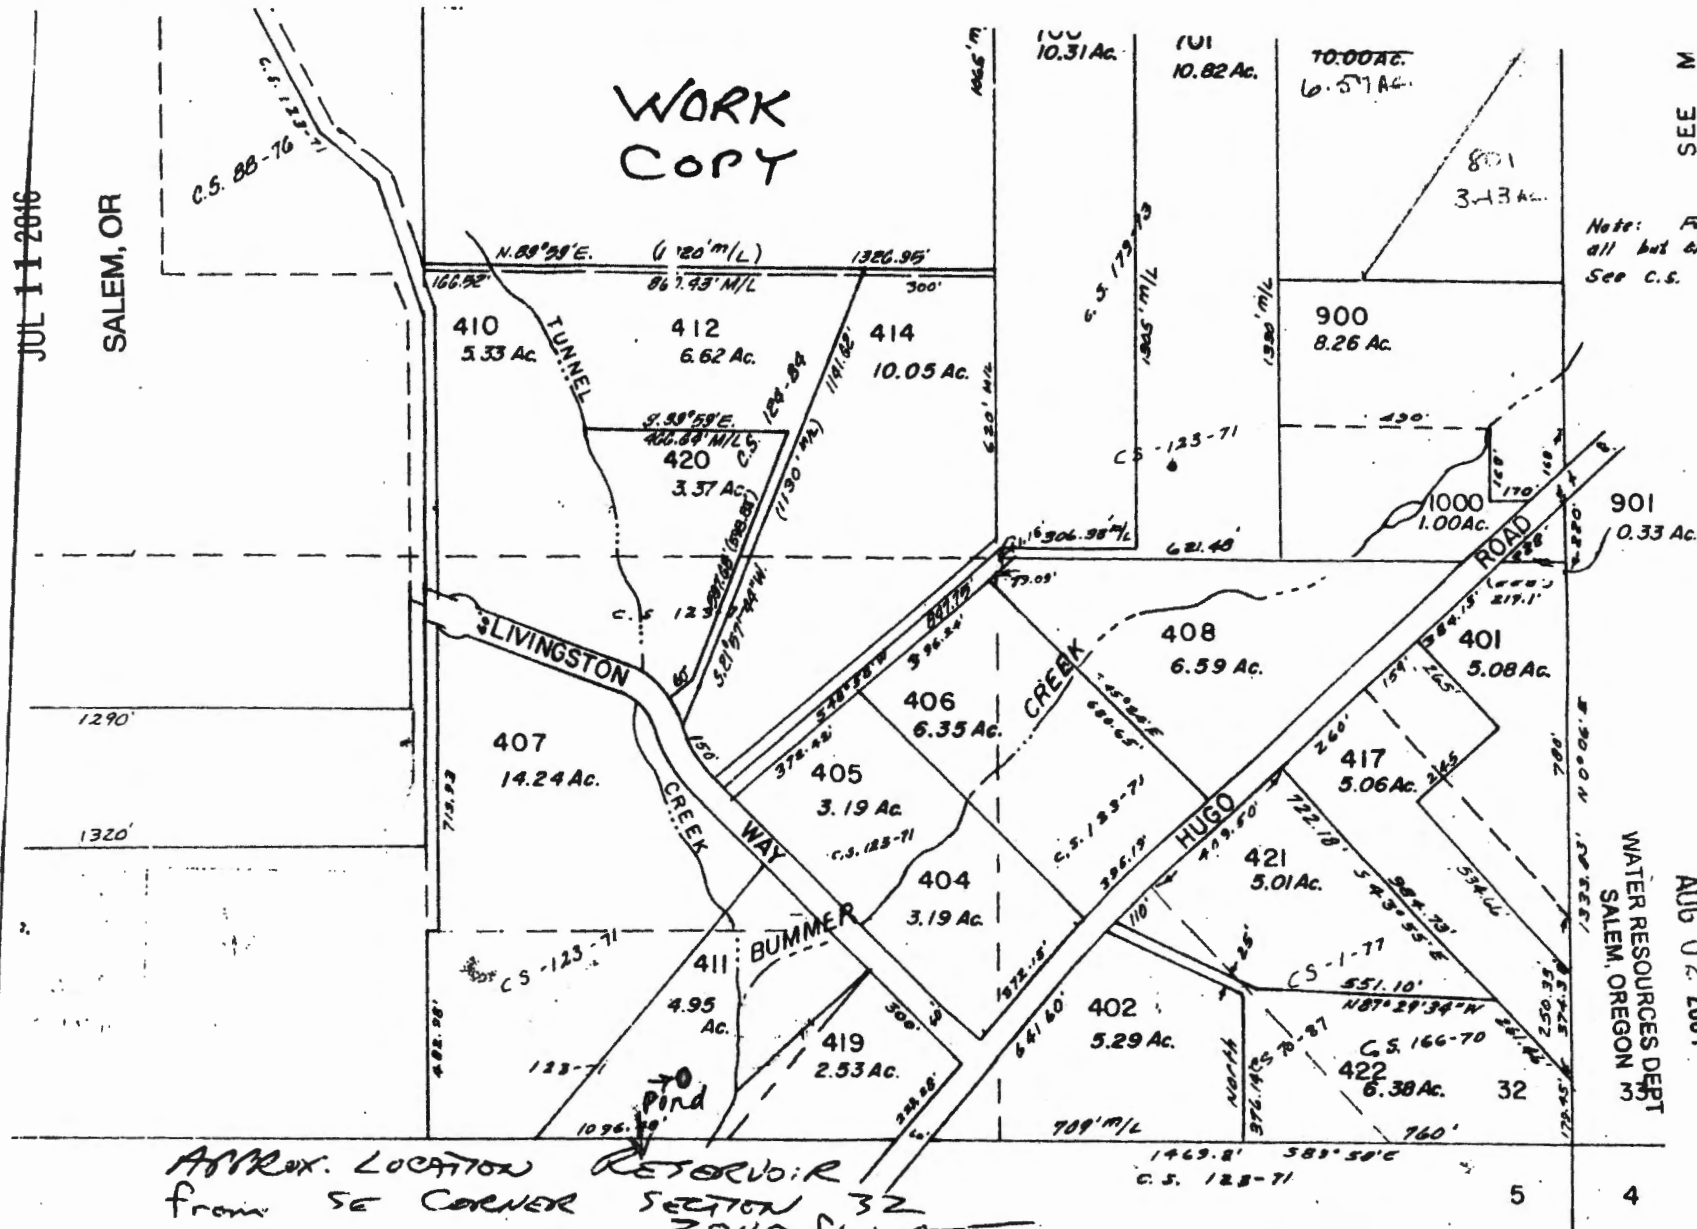

RECEIVED

AUG 02 2004

WATER RESOURCES DEPT
SALEM, OREGON 973

APPROX. LOCATION
from SE CORNER SECTION 32
2040 ft WEST
140 ft NORTH
SEE MAP 35 6 5

34s-6w-32
SW 1/4 SE 1/4

Scale
1" = 400'



app no. R-86062

34s 6w.32