


EXHIBIT B

T30S, R29³/₄E, W.M.
Harney County, Oregon

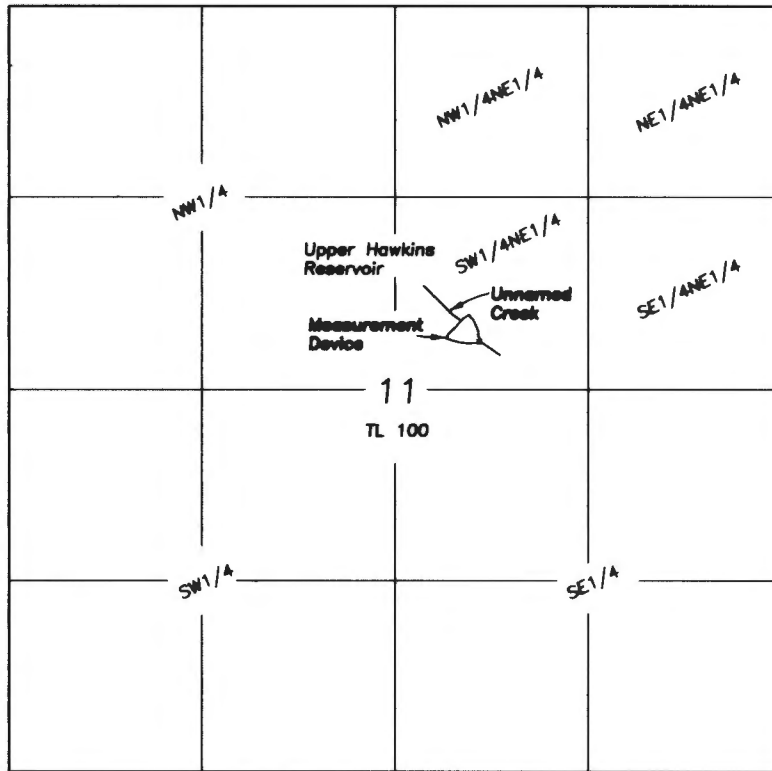

SCALE 1"=1320'

Outlet is located 2280' South & 2280' West of the
NE corner of Section 11.
Measuring device is located 14' North & 32' West of the Outlet.

FINAL PROOF SURVEY
CLAIM OF BENEFICAL USE
UPPER HAWKINS RESERVOIR

For

Bureau of Land Management
January 24, 2017

LEGEND
Application No. R-59658
Permit No. R-8090
Priority 12/21/1979

A portion of Tax Lot
30-29X TL100

NOTE: Tax Lot 100 is owned by the BLM
and is more that 8,300 acres.
No boundaries of the tax lot
can be shown.

Prepared by
Cornerstone Surveying, Inc
P.O. BOX 33
JOHN DAY, OR. 97845
(541)575-1813
cornerstonesurvey@centurytel.net

NOTE: The preparation of this map
was for the purpose of identifying
the location of the proposed water
right and has no intent to provide
dimensions or location of property
ownership lines.

RECEIVED BY OWRD

FEB 06 2017

SALEM, OR

