


Claim of Beneficial Use Map for Teresa & Scott Kelly


Permit #: R-14099

34S-2W-29-tax lot 100

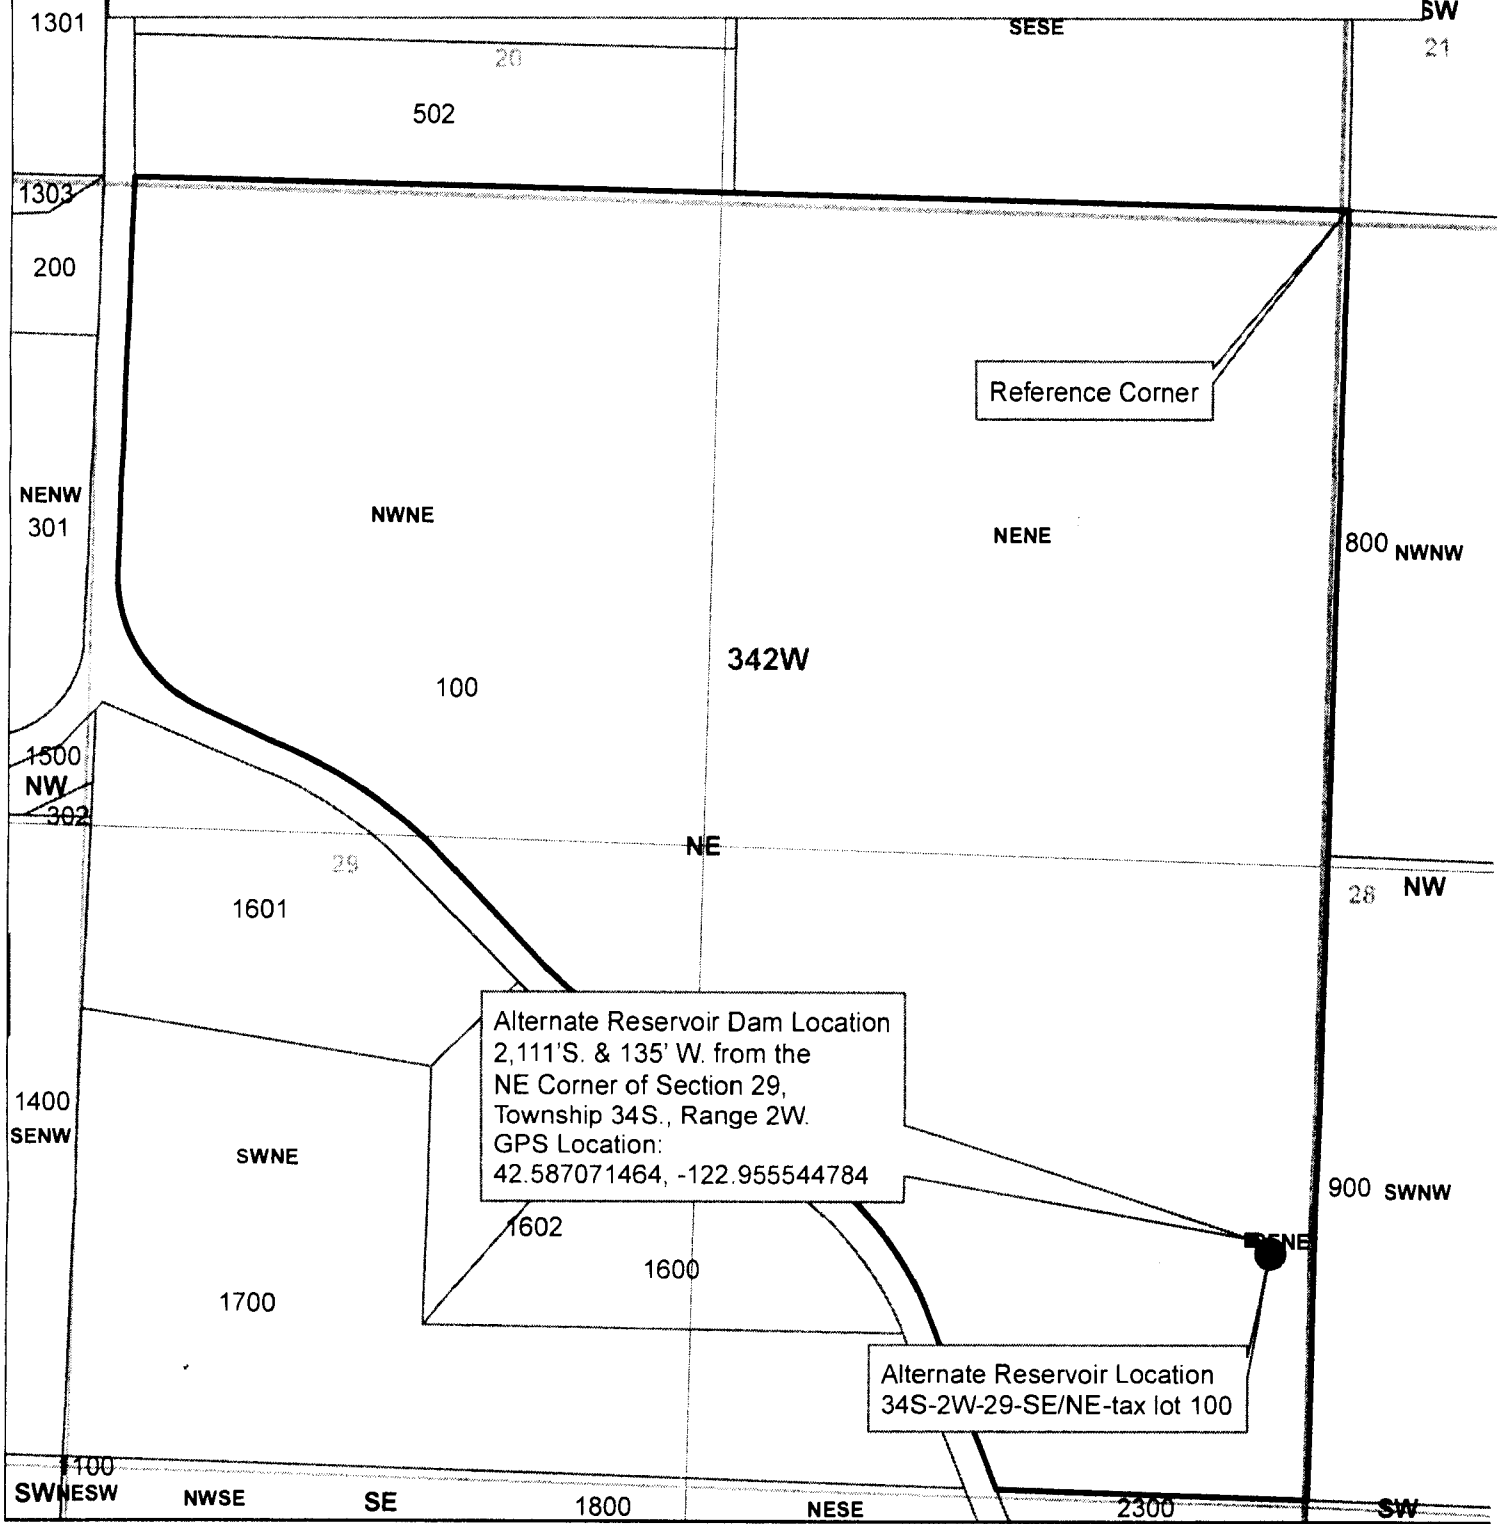

Legend

- Alt. Reservoir Dam Location
- Alternate Reservoir Location
- ▨ Taxlot 100
- ▨ Taxlots
- ▭ Townships
- ▭ Sections
- ▭ Quarter Sections
- ▭ Quarter Quarter Sections

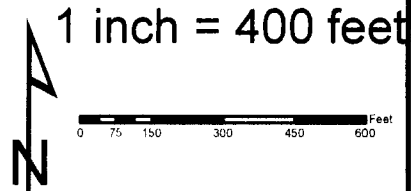

JACKSON COUNTY
WATERMASTER

Prepared by Travis Kelly

This map is based on a digital database compiled by Jackson County from a variety of sources. Jackson County cannot accept responsibility for errors, omissions, or positional accuracy. There are no warranties, expressed or implied.

Date: 05/18/2010 34-2W-29-tax lot 100 CBU Kelly.mxd k