

CLAIM OF BENEFICIAL USE MAP

APPLICATION S-85538 PERMIT S-53981


SUPPLEMENTAL IRRIGATION

FOR

MORRIS AND DANIELLE PENZER
10827 WEST EVANS CREEK ROAD
ROGUE RIVER, OREGON 97537


SITUATED IN

SECTION 28, 29, 32 & 33, TOWNSHIP 34 SOUTH, RANGE 4 WEST, W.M.
JACKSON COUNTY, OREGON

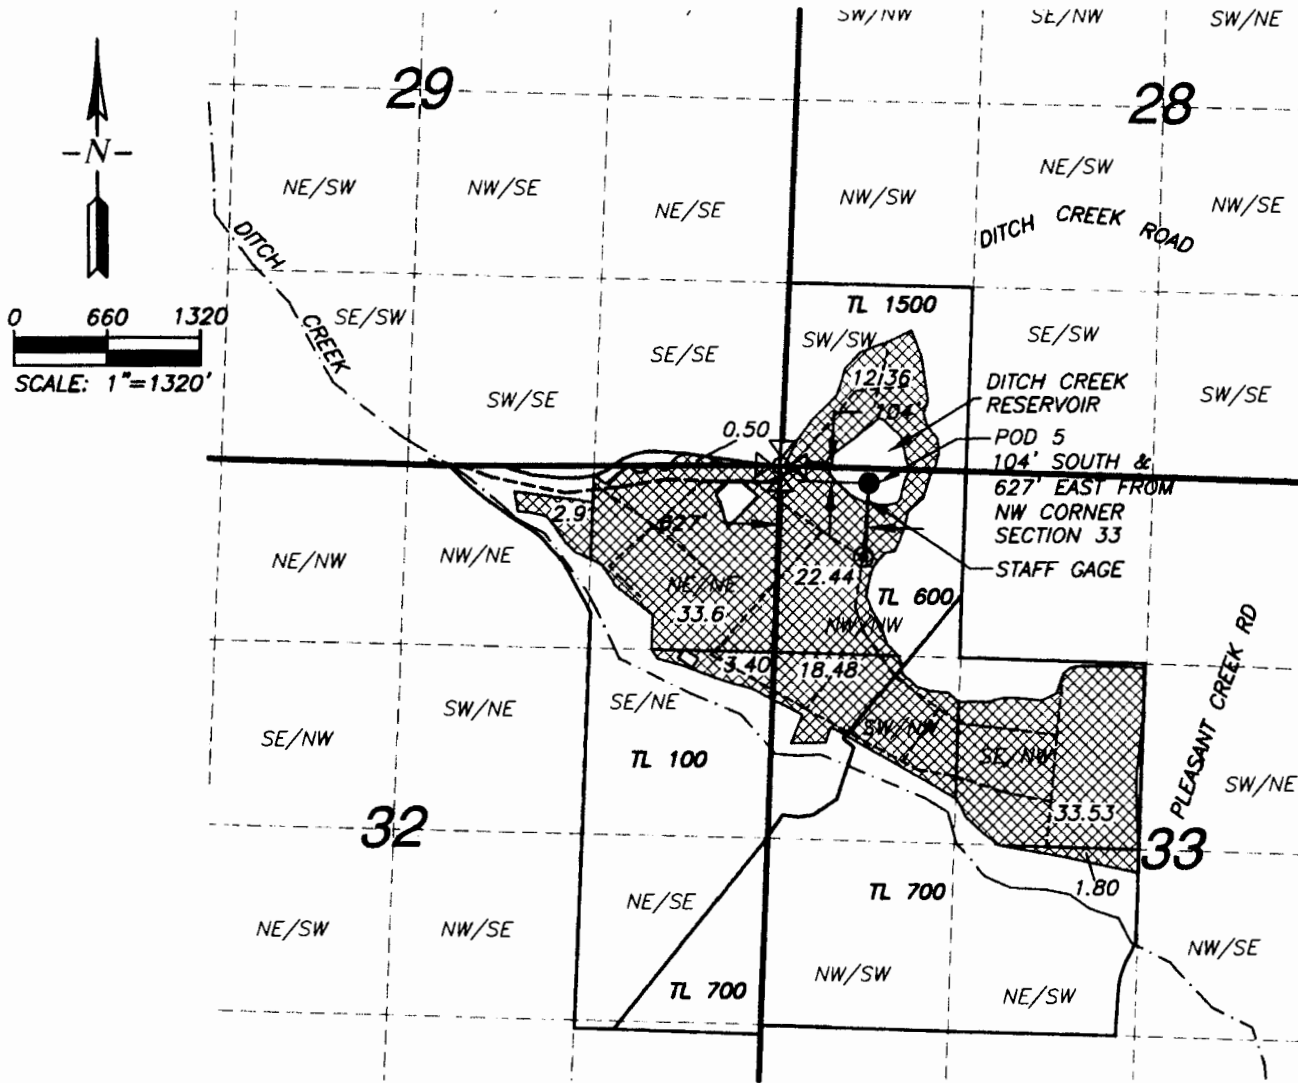

LEGEND

- POINT OF DIVERSION
- PUMP
- 1/4-1/4 SECTION LINE
- RESERVOIR FILL/DRAIN PIPE
- DISTRIBUTION LINES
- PLACE OF USE

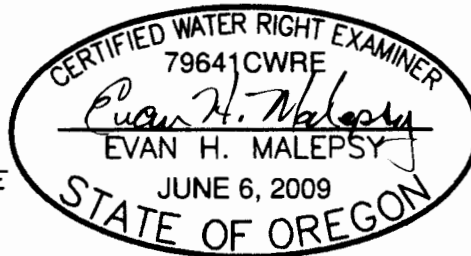

PW Public Works Management, Inc.

This map is not intended to provide legal dimensions or locations of property ownership lines.

RENEWS: 12/31/2012

EHM-March 11, 2011