


T22S, R34E, W.M.
Harney County, Oregon

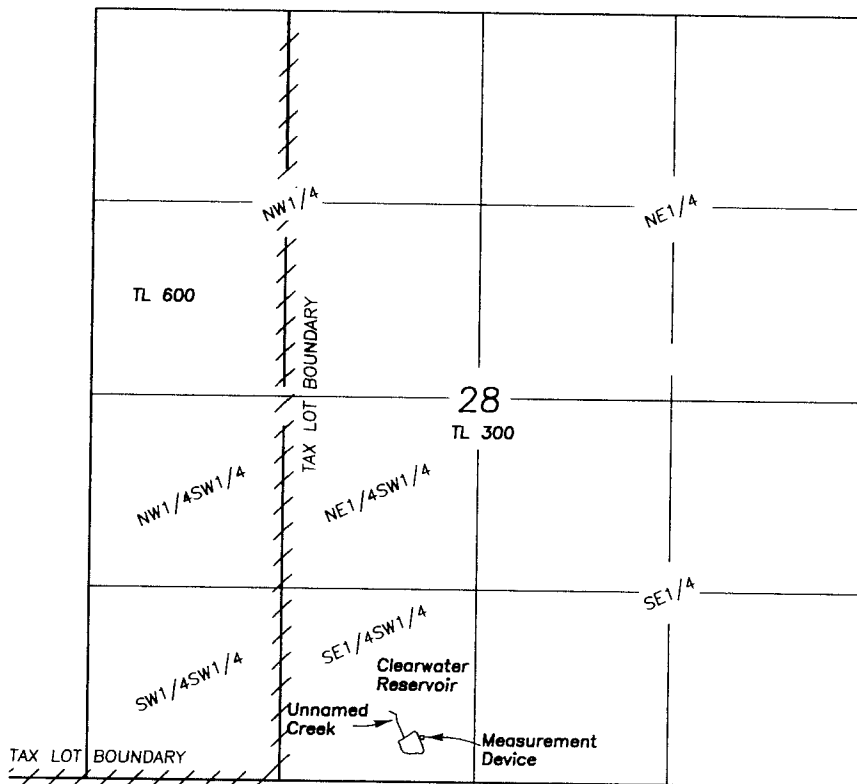

SCALE 1"=1320'

Outlet is located 290' N & 3010' W of the
SE corner of Section 28.

Measuring device is located 7' North of the Outlet

FINAL PROOF SURVEY
CLAIM OF BENEFICIAL USE
CLEARWATER RESERVOIR

For

Bureau of Land Management

October 18, 2016

LEGEND

Application No. R-47270
Permit No. R-7898
Priority 7/24/1970

A portion of Tax Lot
22-34 TL300

NOTE: Tax Lot 300 is owned by the BLM
and is more that 19,000 acres.
Therefore only a portion of the tax
lot boundary can be shown.

NOTE: The preparation of this map
was for the purpose of identifying
the location of the proposed water
right and has no intent to provide
dimensions or location of property
ownership lines.

RECEIVED BY OWRD

NOV 14 2016

SALEM, OR

Prepared by
Cornerstone Surveying, Inc

P.O. BOX 33
JOHN DAY, OR. 97845
(541)575-1813

cornerstonesurvey@centurytel.net

