


T21S, R35E, W.M.
Harney County, Oregon

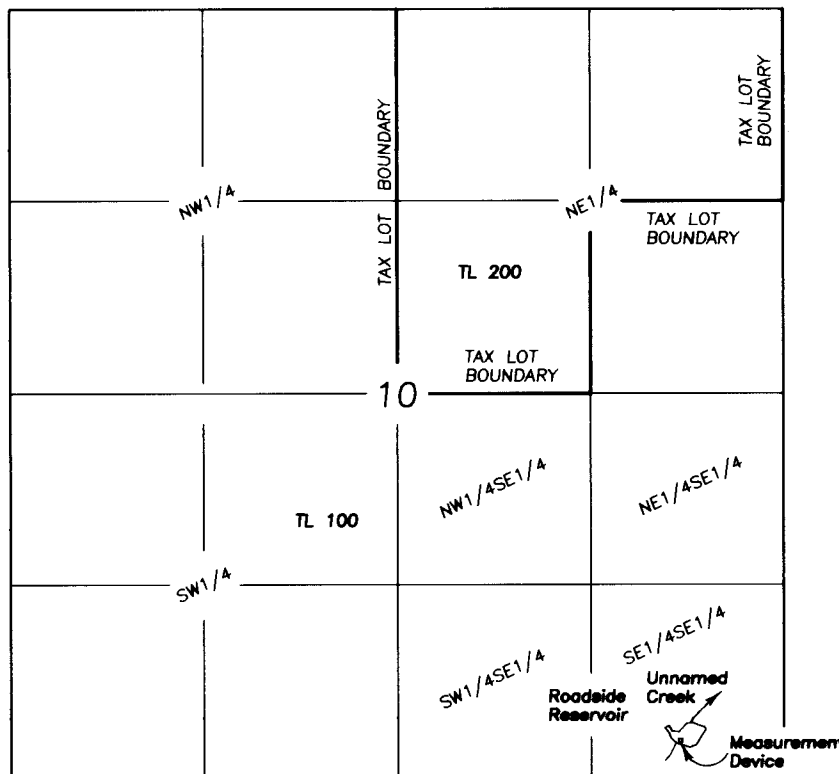

SCALE 1"=1320'

Outlet is located 210' ~~South~~ ^{North} & 750' ~~East~~ ^{West} of the SE corner of Section 10.
Measuring device is located 30' North of the Outlet

FINAL PROOF SURVEY
CLAIM OF BENEFICIAL USE
ROADSIDE RESERVOIR

For

Bureau of Land Management

October 27, 2016

Prepared by

Cornerstone Surveying, Inc

P.O. BOX 33

JOHN DAY, OR. 97845

(541)575-1813

cornerstonesurvey@centurytel.net

LEGEND

Application No. R-45428


Permit No. R-7890

Priority 9/25/1968

A portion of Tax Lot
21-35 TL100

NOTE: Tax Lot 100 is owned by the BLM and is more that 14,000 acres. Therefore only a portion of the tax lot boundary can be shown.

NOTE: The preparation of this map was for the purpose of identifying the location of the proposed water right and has no intent to provide dimensions or location of property ownership lines.

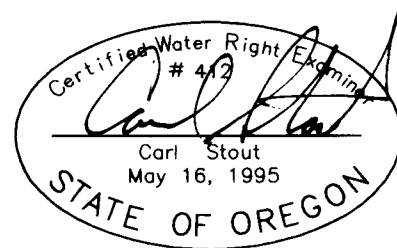

This map has been amended by OWRD to correct the direction of the measured distance. ^{Wayc} _{ask} 11-22