


T23S, R34E, W.M.
Harney County, Oregon

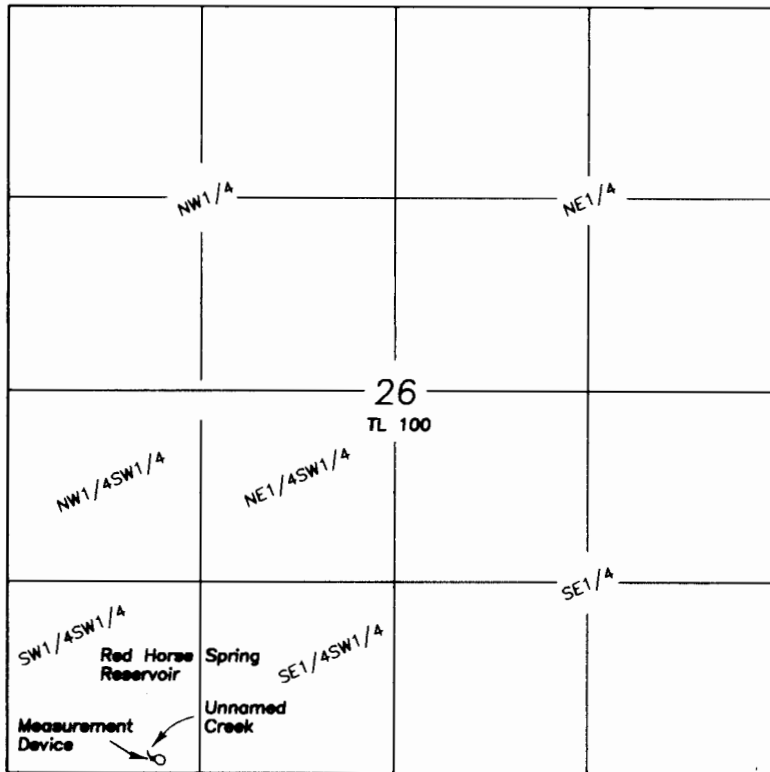

SCALE 1"=1320'

Outlet is located 100' N & 4270' W of the
SE corner of Section 26.

Measuring device is located 6' North & 4' West of the Outlet

FINAL PROOF SURVEY
CLAIM OF BENEFICIAL USE
RED HORSE SPRING RESERVOIR

For

Bureau of Land Management

October 17, 2016

LEGEND

Application No. R-66486
Permit No. R-11097
Priority 1/16/1985

A portion of Tax Lot
23-34 TL100

NOTE: Tax Lot 100 is owned by the BLM
and is more that 14,000 acres.
No tax lot boundaries can be shown.

NOTE: The preparation of this map
was for the purpose of identifying
the location of the proposed water
right and has no intent to provide
dimensions or location of property
ownership lines.

Prepared by
Cornerstone Surveying, Inc

P.O. BOX 33
JOHN DAY, OR. 97845
(541)575-1813

cornerstonesurvey@centurytel.net

RECEIVED BY OWRD

NOV 14 2016

SALEM, OR

