


T20S, R36E, W.M.
Harney County, Oregon

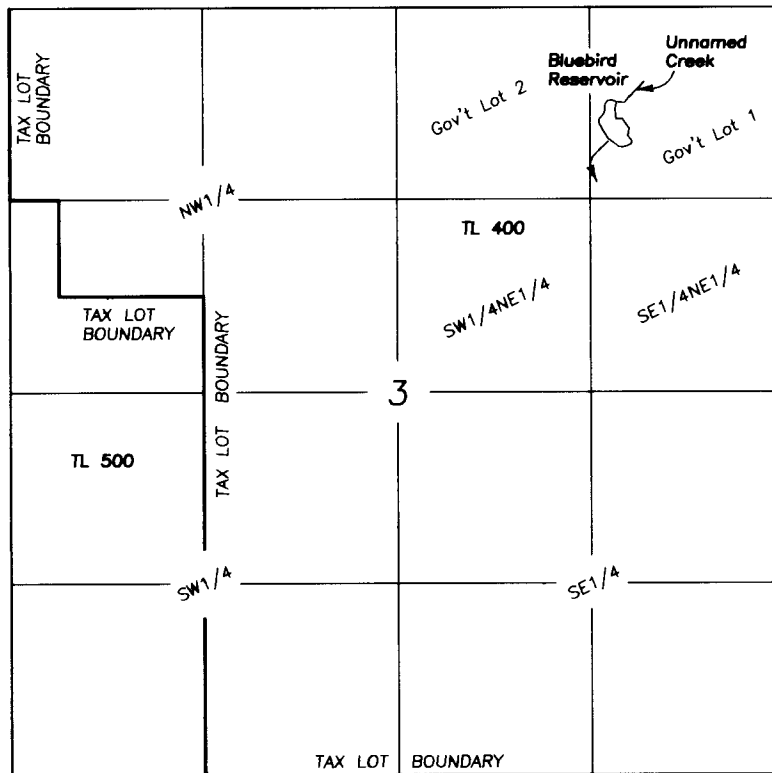

SCALE 1"=1320'

Outlet is located 1000' South & 1100' West of the
NE corner of Section 3.

FINAL PROOF SURVEY
CLAIM OF BENEFICIAL USE
BLUEBIRD RESERVOIR

For

Bureau of Land Management

October 27, 2016

LEGEND

Application No. R-49491
Permit No. R-7912
Priority 7/21/1972

A portion of Tax Lot
20-36 TL400

NOTE: Tax Lot 400 is owned by the BLM
and is more that 10,000 acres.
Therefore only a portion of the tax
lot boundary can be shown.

Prepared by

Cornerstone Surveying, Inc

P.O. BOX 33
JOHN DAY, OR. 97845

(541)575-1813

cornerstonesurvey@centurytel.net

NOTE: The preparation of this map
was for the purpose of identifying
the location of the proposed water
right and has no intent to provide
dimensions or location of property
ownership lines.

RECEIVED BY OWRD

NOV 18 2016

SALEM, OR

