

**CLAIM OF BENEFICIAL USE MAP**  
**APPLICATION S-70852 PERMIT 52226**  
**LOCATED IN THE SE¼ NW¼ & NE¼ SW¼ OF**  
**SECTION 1, TOWNSHIP 27 SOUTH, RANGE 13 WEST, W.M.**  
**COOS COUNTY, OREGON**

PREPARED FOR: FRANK & CLEO BRETT  
 PREPARED BY: DENNIS GOUDE  
 DATE PREPARED: JUNE 2, 2011

Scale 1"=400'

**LEGEND**


P.O.B. 

P.O.D. 

PIPE 

IRRIGATED ACRES 

SE¼ NW¼  
 1.4 + ACRES  
 NE¼ SW¼  
 0.4 ACRES

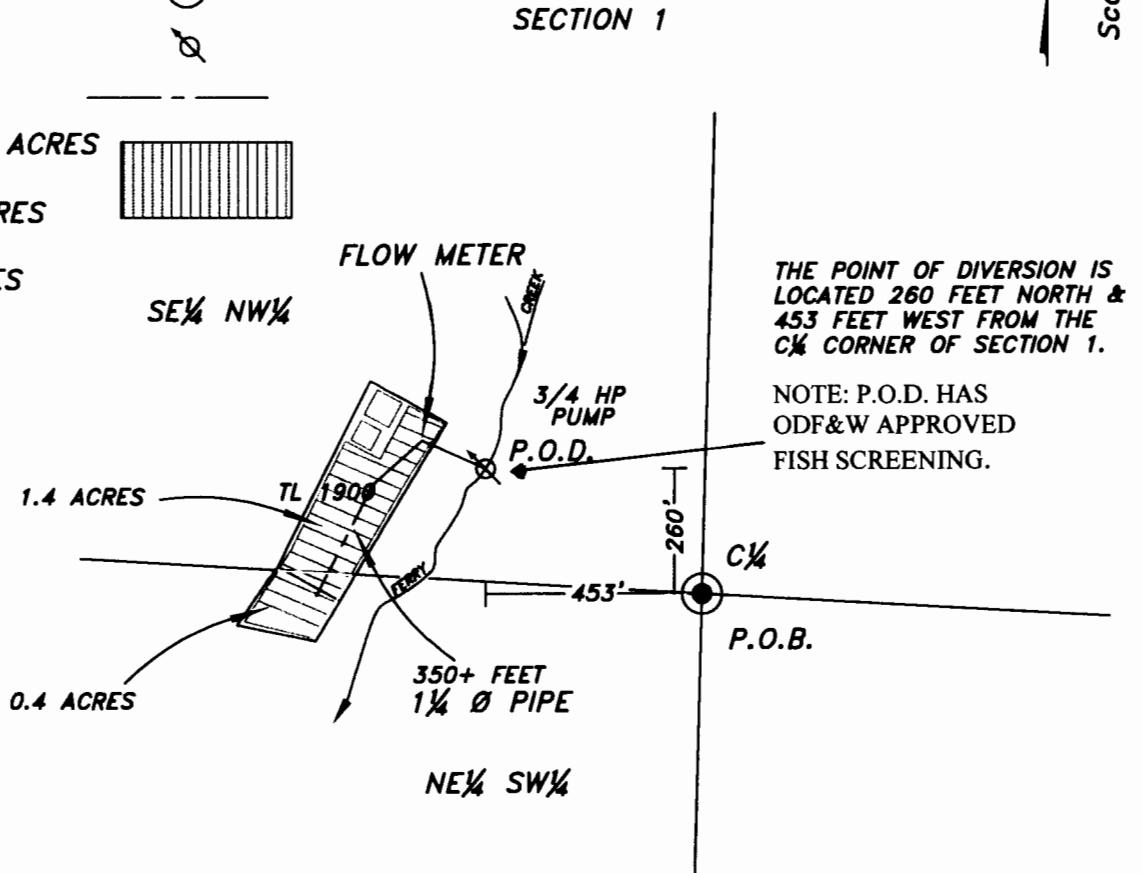

EXPIRES 6/30/2012

**EXAMINERS DISCLAIMER STATEMENT**

The preparation of this map was for the purpose of identifying the location of the Water Right only and has no intent to provide dimensions or location of property ownership lines.

**Stuntzner Engineering & Forestry, L.L.C.**

ENGINEERING • LAND SURVEYING • FORESTRY  
 PLANNING • WATER RIGHTS

700 South 4th St. Phone: (541) 267-2672  
 Post Office Box 118 Fax: (541) 267-6222  
 Coos Bay, Oregon 97402