


Walla Walla River Irrigation District

3201 Water Rights Map

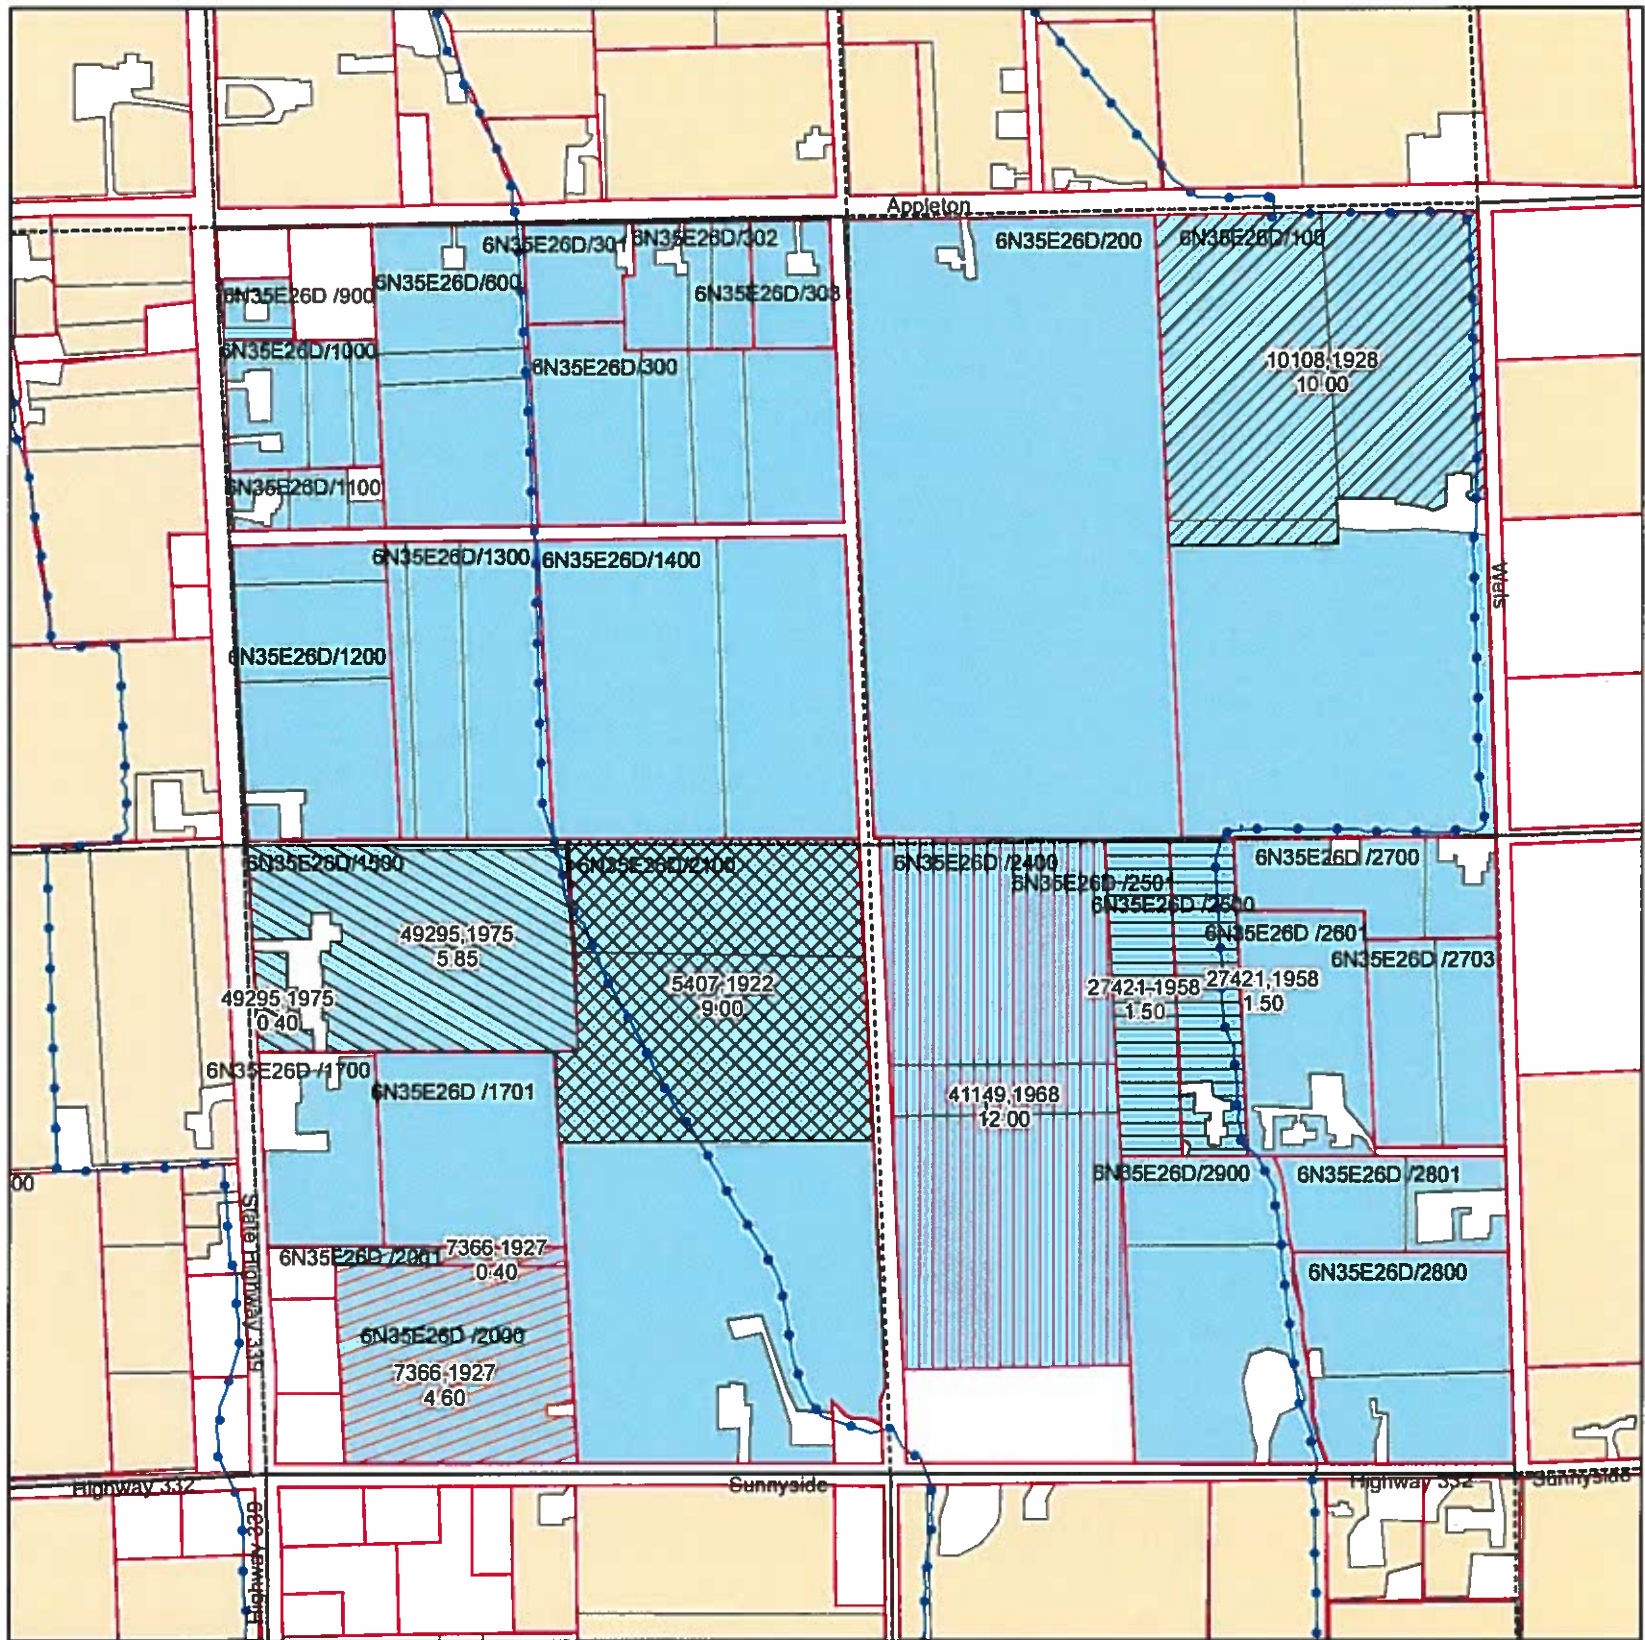

T6N R35E WM Section 26 SE Quarter

ASSESSORMAP	CERTIFICATE	PRIORITY	QQ	WR ACRES
6N35E26D/100	X 10108	8/3/1928	NESE	10.00
6N35E26D/1500	X 49295	11/3/1975	SWSE	0.40
6N35E26D/1500	X 49295	11/3/1975	SWSE	5.85
6N35E26D/2000	X 7366	4/4/1927	SWSE	4.60
6N35E26D/2001	X 7366	4/4/1927	SWSE	0.40
6N35E26D/2100	X 5407	7/6/1922	SWSE	9.00
6N35E26D/2400	X 41149	4/4/1968	SESE	12.00
6N35E26D/2500	X 27421	4/17/1958	SESE	1.50
6N35E26D/2501	X 27421	4/17/1958	SESE	1.50



Legend

- PIPE
- Parcel
- QCDB
- WWRID Boundary

CERTIFICATE, PRIORITY

- 10108, 1928 X IS
- 27421, 1958 X IS
- 41149, 1968 X IR+IS - dim 20ac? No = cancel
- 49295, 1975 X IS
- 5407, 1922 X
- 7366, 1927 X

Primary Rights

- Primary Rights
- Water Rights Not Within Quarter



Date May 2011

IS 26 SE