


Sec. 36 T.10S. R.8W.W.M.

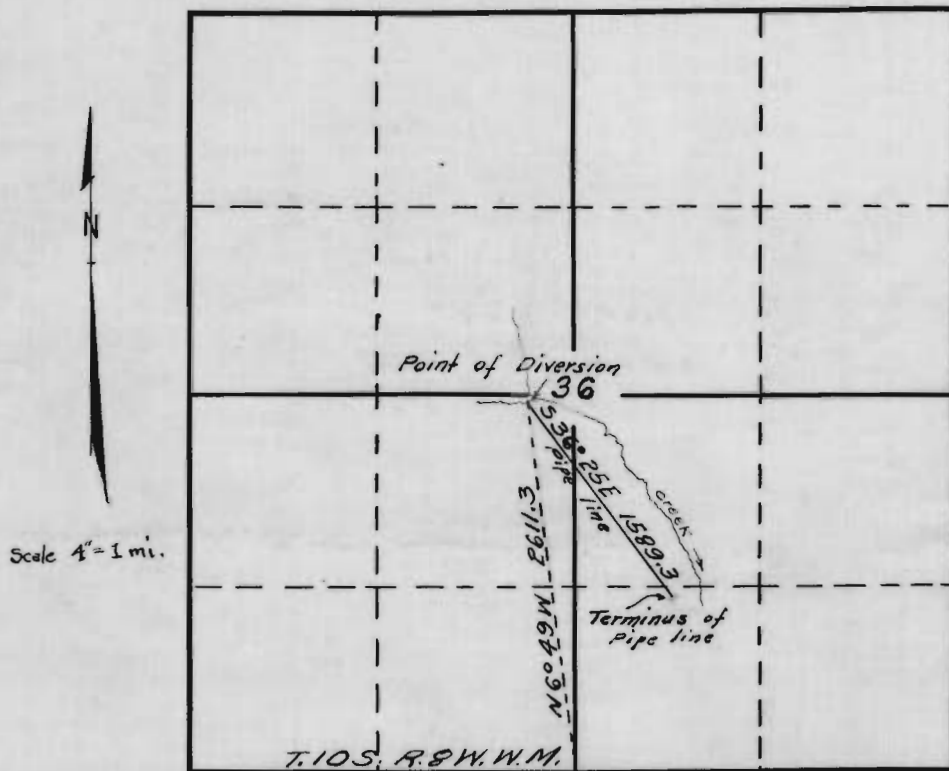

I, H.M. Teel, County surveyor of Lincoln County, Oregon do hereby certify that the above map was made from notes taken during an actual survey made by me on July 11, 1930 and that it correctly represents the works described in the accompanying application together with the location of other streams and ditches in the immediate vicinity.

Oregon No. 1013

H. M. Teel  
Registered Professional Engineer  
May 8, 1920.

Application No. 13587  
Permit No. 9755

