


Walla Walla River Irrigation District

3201 Water Rights Map

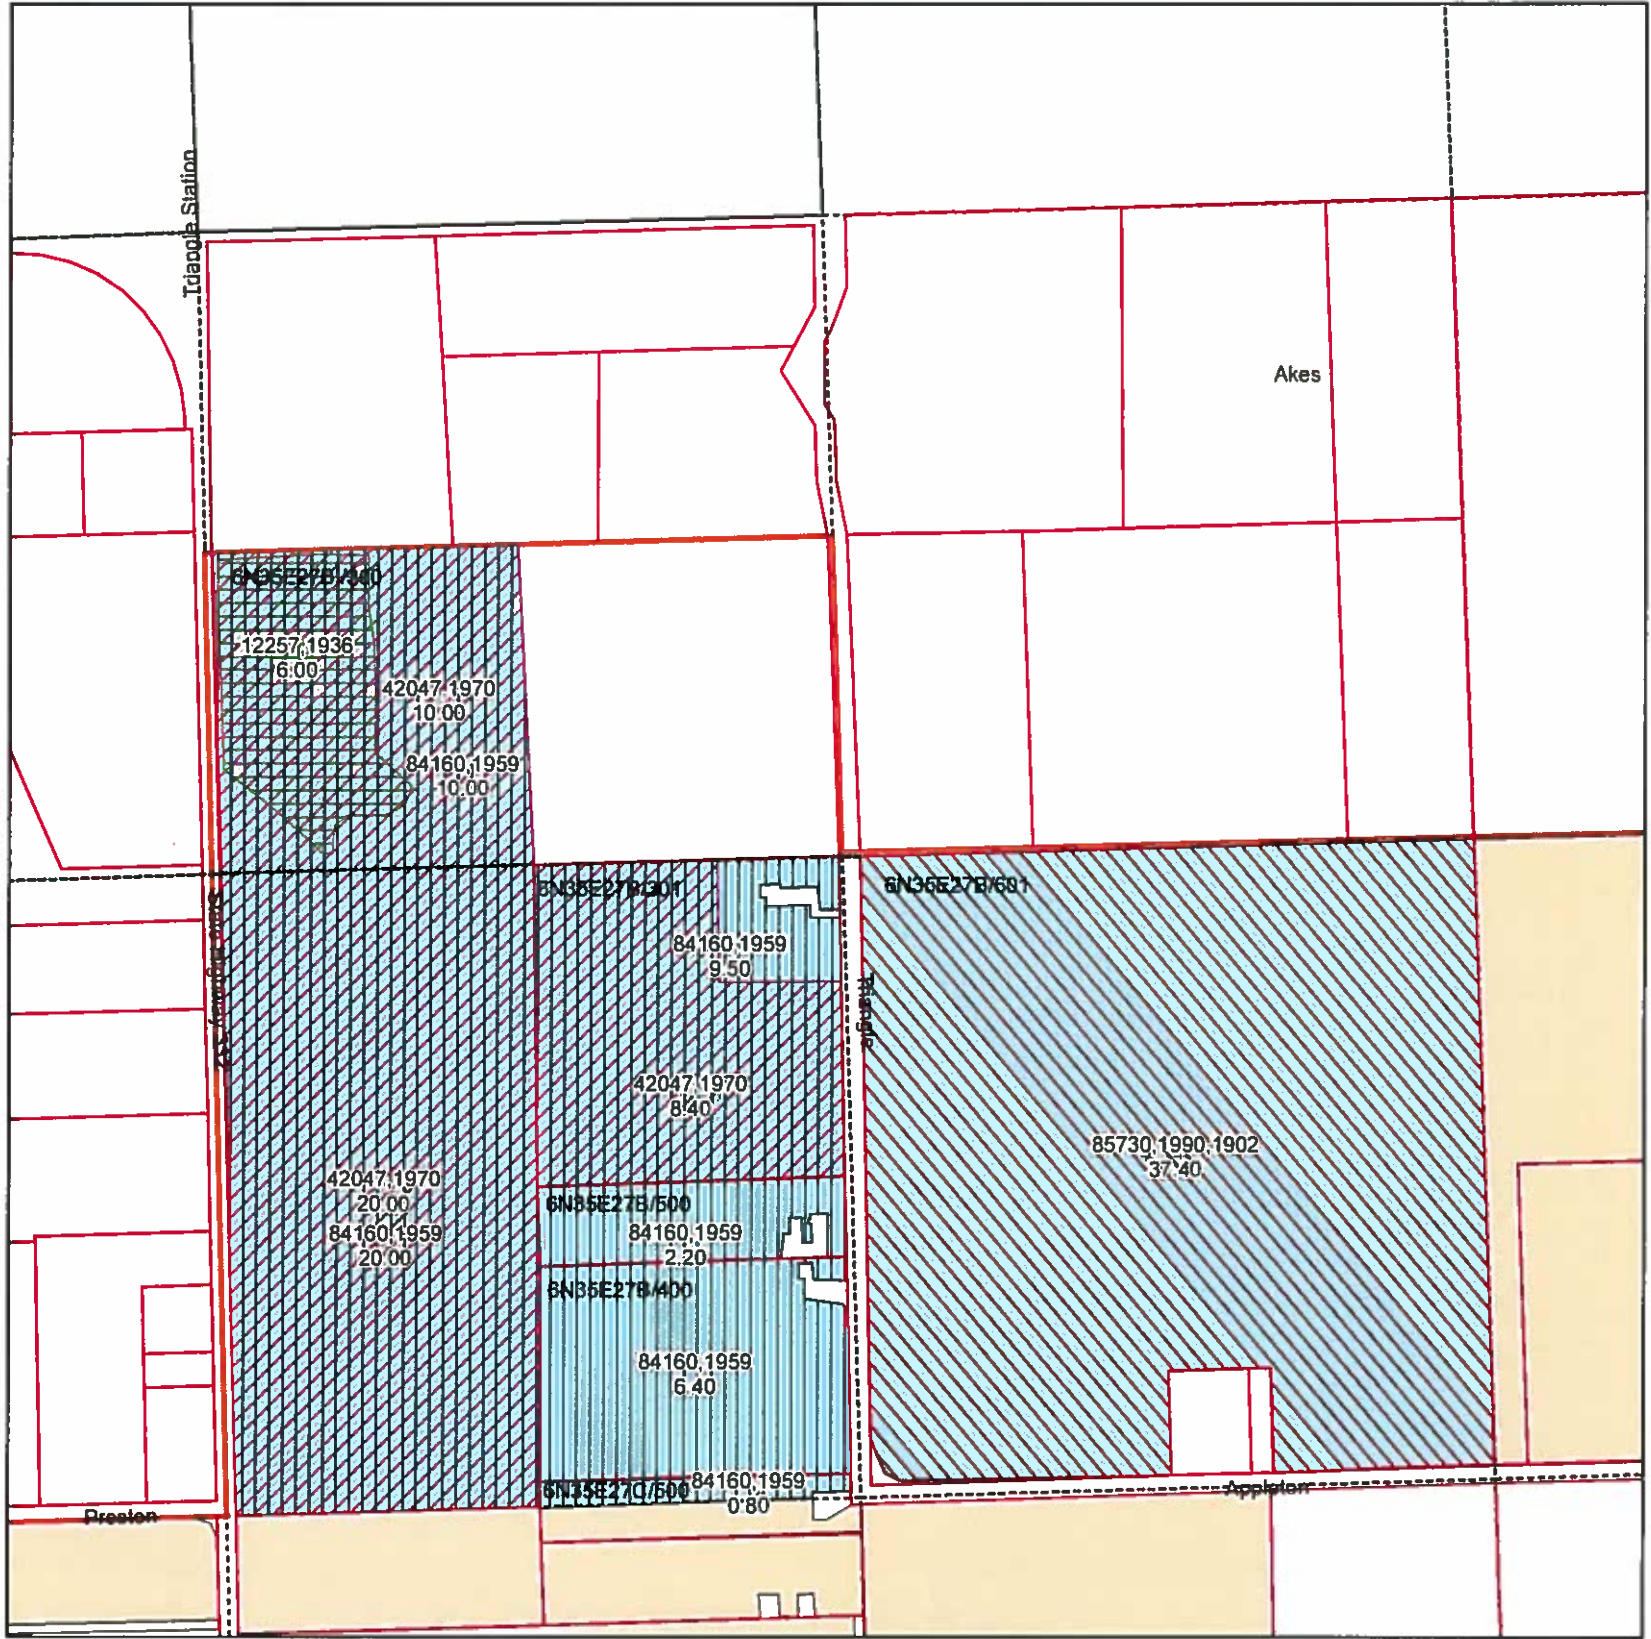





T6N R35E WM Section 27 NW Quarter

ASSESSORMAP	CERTIFICATE	PRIORITY	QQ	WR ACRES
6N35E27B/300	X 12257	9/11/1936	NWNW	6.00
6N35E27B/300	✓ 84160	1959	SWNW	20.00
6N35E27B/300	X 42047	7/31/1970	SWNW	20.00
6N35E27B/300	X 42047	7/31/1970	NWNW	10.00
6N35E27B/300	✓ 84160	1959	NWNW	10.00
6N35E27B/301	X 42047	7/31/1970	SWNW	8.40
6N35E27B/301	✓ 84160	1959	SWNW	9.50
6N35E27B/400	84160	1959	SWNW	6.40
6N35E27B/500	✓ 84160	1959	SWNW	2.20
6N35E27B/601	X 85730	1990, 1902	SESW	37.40
6N35E27C/500	✓ 84160	1959	SWNW	0.80







Supplemental Rights

- CERTIFICATE, PRIORITY**
-  12257, 1936
 -  42047, 1970
 -  84160, 1959 *86/64*
 -  85730, 1990, 1902 *1992*

Primary Rights

-  Primary Rights
-  Water Rights Not Within Quarter

Legend

-  PIPE
-  Parcel
-  QCDB
-  WWRID Boundary

needs differentiated

Supplemental Rights



