


Walla Walla River Irrigation District

3201 Water Rights Map

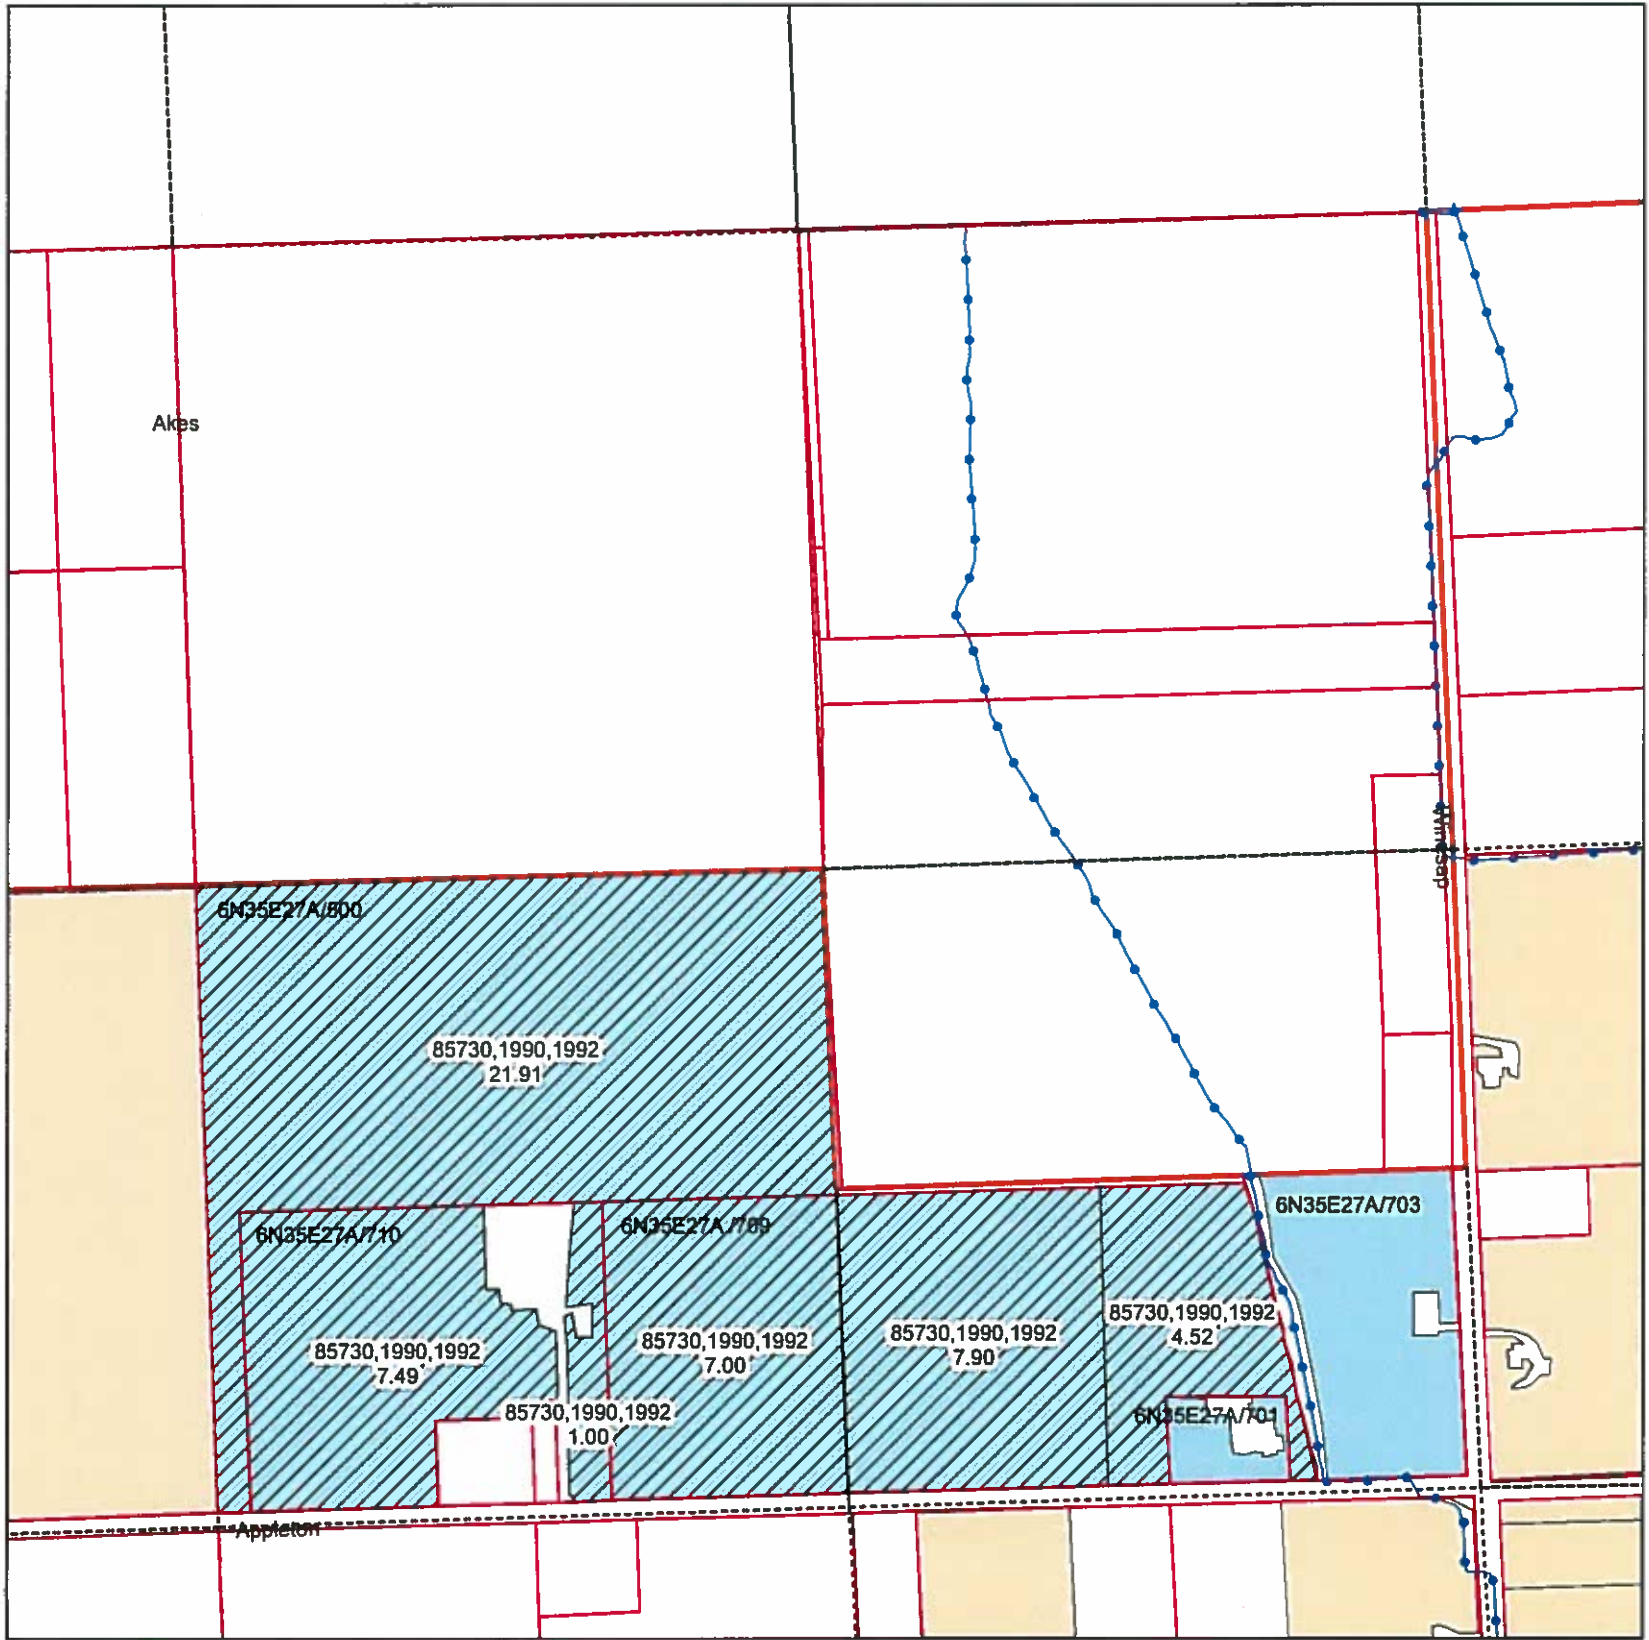

T6N R35E WM Section 27 NE Quarter



ASSESSORMAP	CERTIFICATE	PRIORITY	QQ	WR ACRES
6N35E27A/500	x 85730	1990,1992	SWNE	21.91
6N35E27A/709	y 85730	1990,1992	SWNE	7.00
6N35E27A/709	x 85730	1990,1992	SENE	7.90
6N35E27A/709	y 85730	1990,1992	SENE	4.52
6N35E27A/710	y 85730	1990,1992	SWNE	7.49
6N35E27A/710	y 85730	1990,1992	SWNE	1.00

Supplemental Rights CERTIFICATE, PRIORITY

85730, 1990, 1992

Primary Rights

Primary Rights
 Water Rights Not Within Quarter

Legend

PIPE
 Parcel
 QCDB
 WWRID Boundary

Supplemental Rights


49.82
37.40 8722

0 400 800 Feet

Date May 2011

Walla Walla River Irrigation District

3201 Water Rights Map

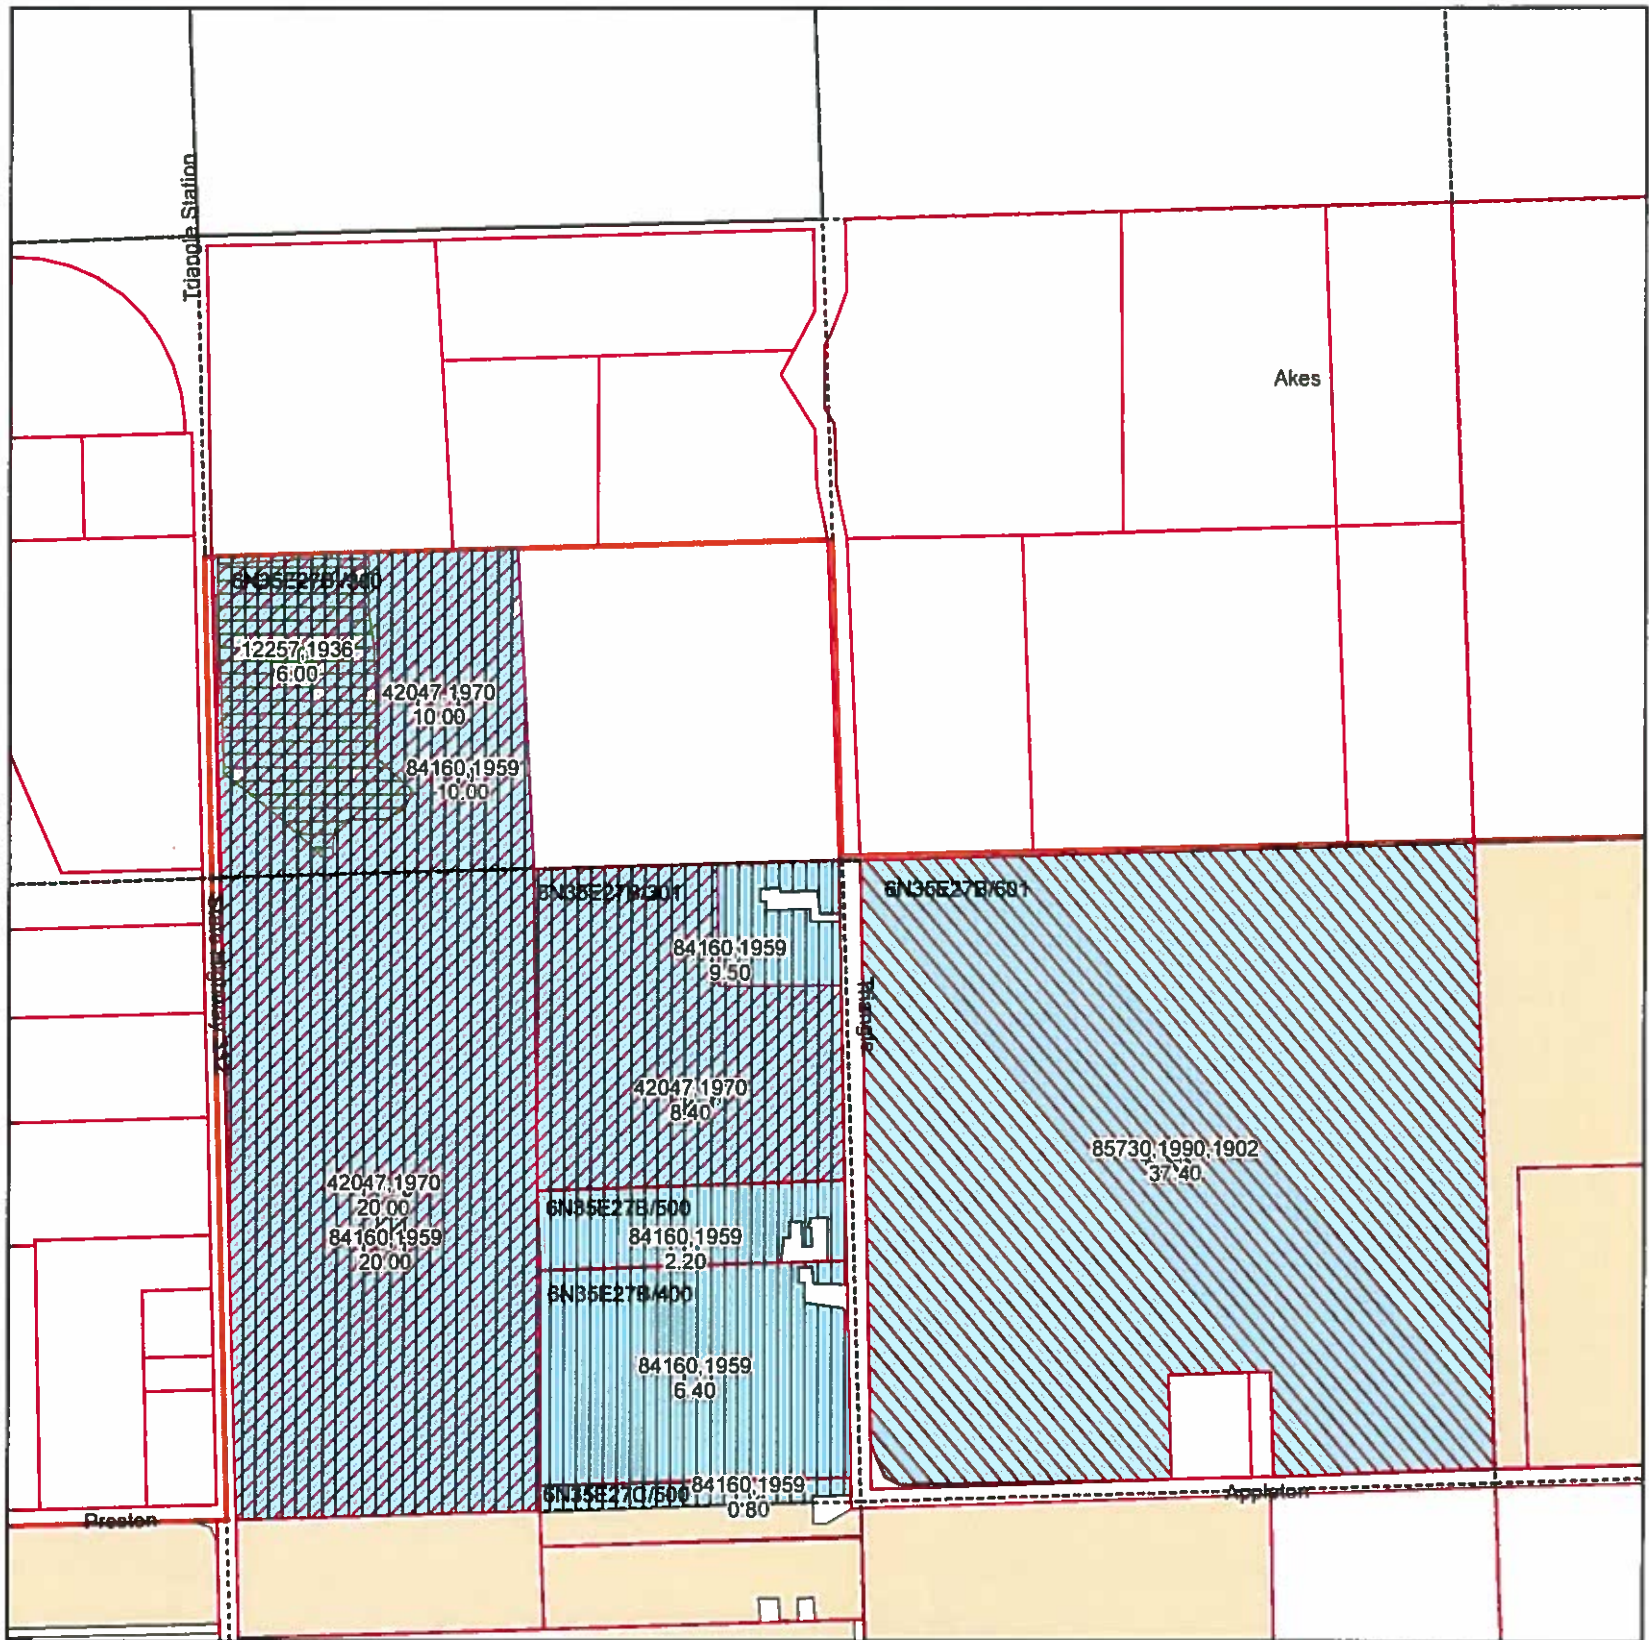

T6N R35E WM Section 27 NW Quarter

ASSESSORMAP	CERTIFICATE	PRIORITY	QQ	WR ACRES
6N35E27B/300	X 12257	^{9/11/} 1936	NWNW	6.00
6N35E27B/300	✓ 84160	1959	SWNW	20.00
6N35E27B/300	X 42047	^{3/31/} 1970	SWNW	20.00 ✓
6N35E27B/300	X 42047	^{3/31/} 1970	NWNW	10.00 ✓
6N35E27B/300	✓ 84160	1959	NWNW	10.00
6N35E27B/301	X 42047	^{3/31/} 1970	SWNW	8.40 ✓
6N35E27B/301	✓ 84160	1959	SWNW	9.50
6N35E27B/400	84160	1959	SWNW	6.40
6N35E27B/500	✓ 84160	1959	SWNW	2.20
6N35E27B/601	X 85730	1990, ¹⁹⁹² 1902	SEnw	37.40
6N35E27C/500	✓ 84160	1959	SWNW	0.80 ✓



Supplemental Rights

CERTIFICATE, PRIORITY

- 12257, 1936
- 42047, 1970
- 84160, 1959 ^{8/6/64}
- 85730, 1990, ¹⁹⁹²1902

Primary Rights

- Primary Rights
- Water Rights Not Within Quarter

Legend

- PIPE
- Parcel
- QCDB
- WWRID Boundary

needs differentiated

Supplemental Rights

