


Walla Walla River Irrigation District

3201 Water Rights Map



T6N R35E WM Section 27 SW Quarter

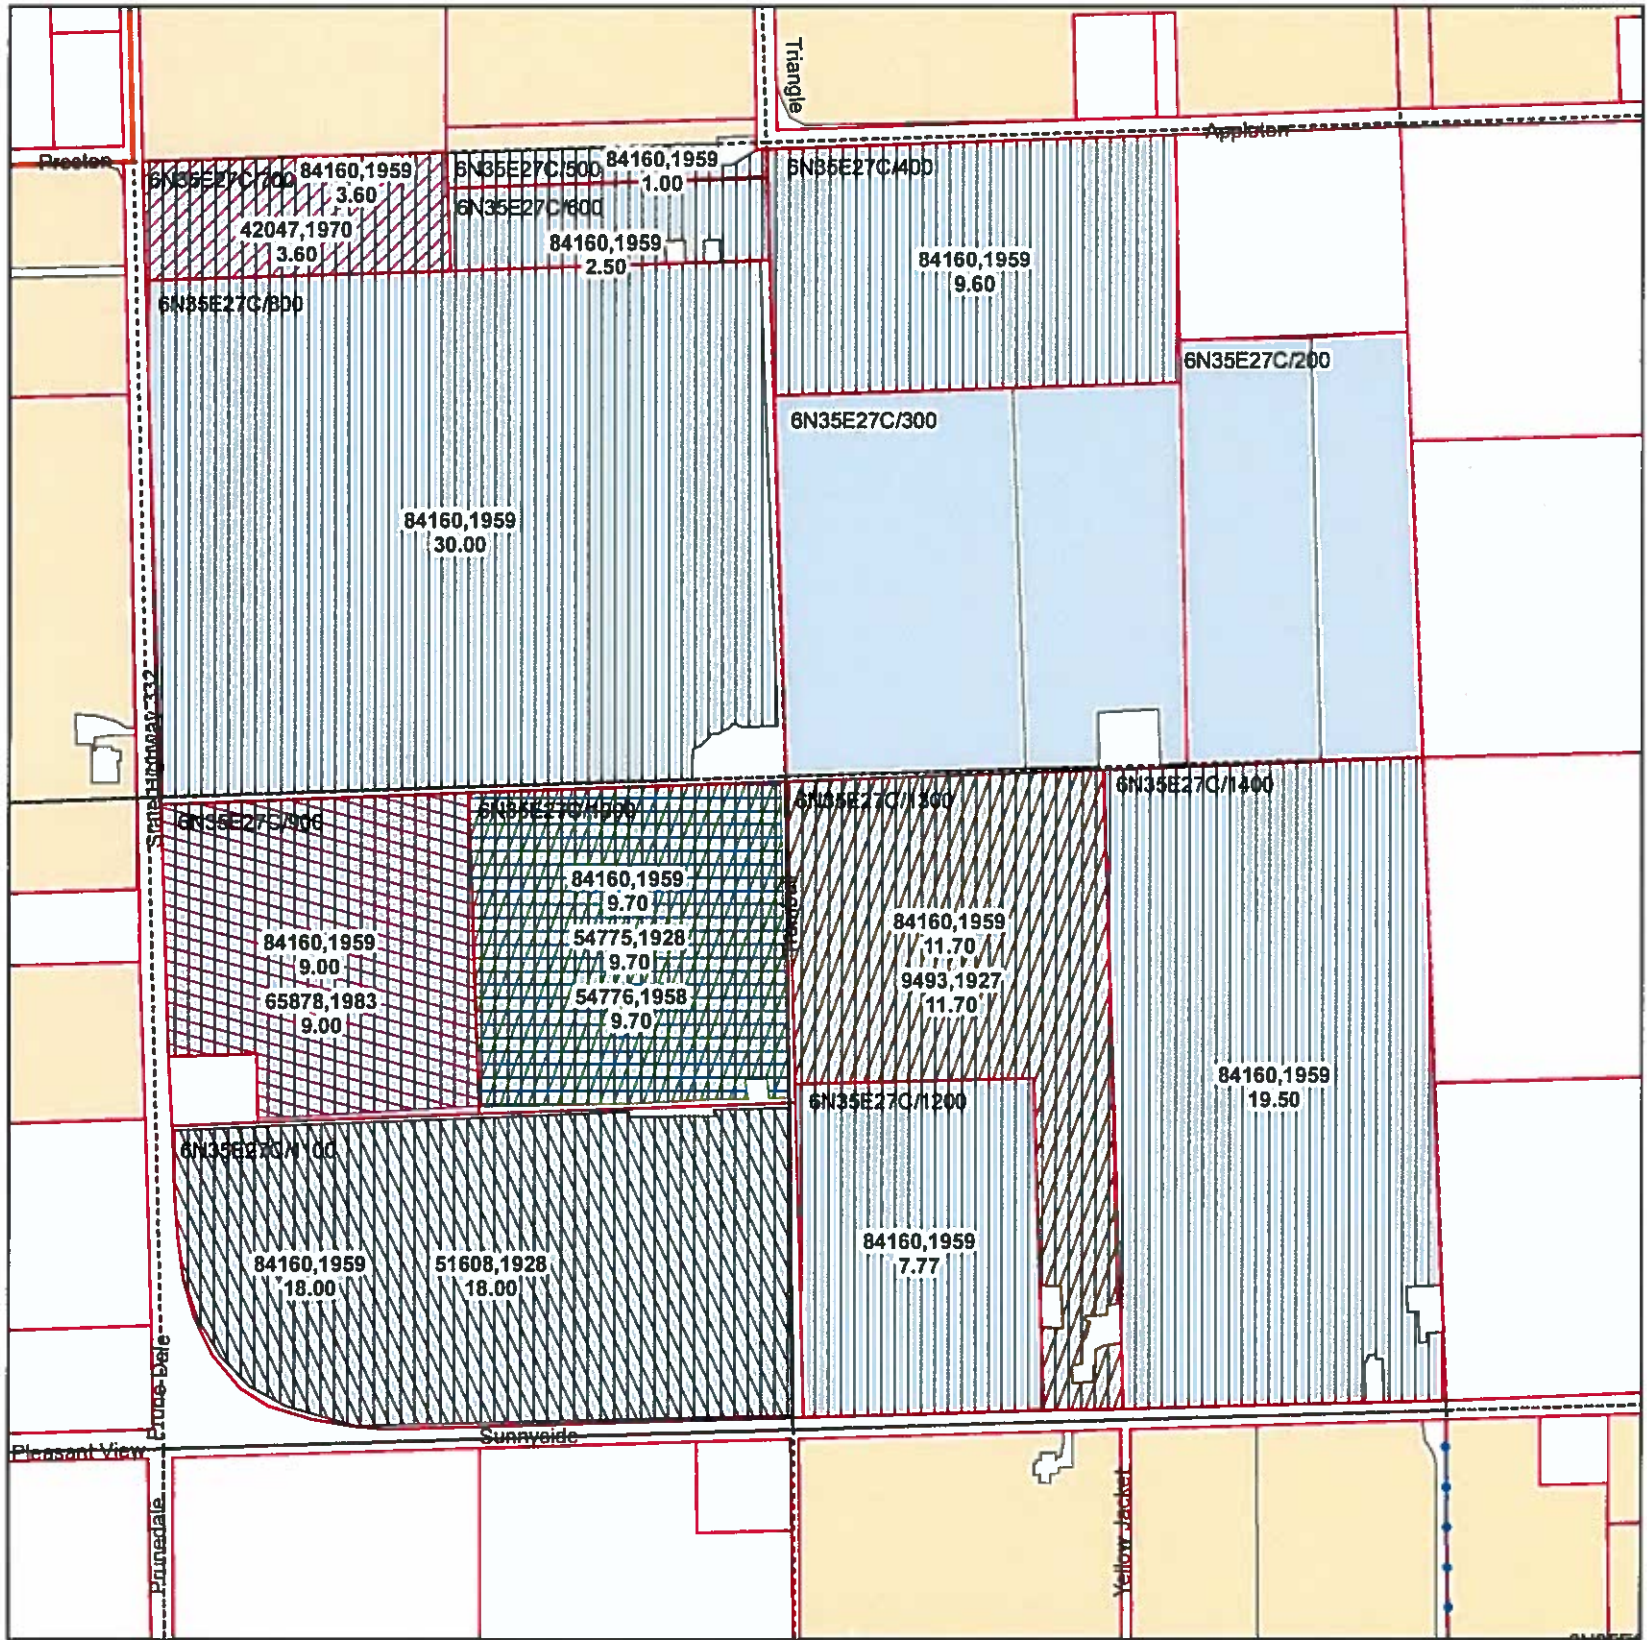

ASSESSORMAP	CERTIFICATE	PRIORITY	QQ	WR ACRES
6N35E27C/1000	X 54775	1928	SWSW	9.70
6N35E27C/1000	✓ 84160	1959	SWSW	9.70
6N35E27C/1000	X 54776	1958	SWSW	9.70
6N35E27C/1100	X 51608	1928	SWSW	18.00
6N35E27C/1100	✓ 84160	1959	SWSW	✓18.00
6N35E27C/1200	✓ 84160	1959	SESW	✓ 7.77
6N35E27C/1300	✓ 84160	1959	SESW	✓ 11.70
6N35E27C/1300	X 9493	1927	SESW	11.70
6N35E27C/1400	✓ 84160	1959	SESW	✓19.50
6N35E27C/400	✓ 84160	1959	NESW	9.60 ✓
6N35E27C/500	✓ 84160	1959	NWSW	1.00 ✓
6N35E27C/600	✓ 84160	1959	NWSW	2.50 ✓
6N35E27C/700	✓ 84160	1959	NWSW	3.60 ✓
6N35E27C/700	X 42047	3/21 1970	NWSW	3.60
6N35E27C/800	✓ 84160	1959	NWSW	30.00 ✓
6N35E27C/900	✓ 84160	1959	SWSW	9.00 ✓
6N35E27C/900	X 65878	2/2 1983	SWSW	9.00

Supplemental Rights

- CERTIFICATE, PRIORITY**
- 42047, 1970
 - 51608, 1928
 - 54775, 1928
 - 54776, 1958
 - 65878, 1983
 - 9493, 1927
 - 84160, 1959 86964

Primary Rights

- Primary Rights
- Water Rights Not Within Quarter

Legend

- PIPE
- Parcel
- QCDB
- WWRID Boundary

Supplemental Rights

