

I H. M. Teal of Toledo, Oregon

DO HEREBY CERTIFY THAT THIS MAP WAS MADE FROM NOTES TAKEN DURING AN ACTUAL SURVEY MADE BY ME ON MAY 7 1930. AND THAT IT CORRECTLY REPRESENTS THE WORK DESCRIBED IN THE ACCOMPANYING APPLICATION. TOGETHER WITH THE LOCATION OF SPRING AND CREEK IN THE IMMEDIATE VICINITY.

H. M. Teal


REGISTERED PROFESSIONAL ENGINEER.

OREGON NO 1013

SCALE 2 IN. = 1 MI.

5/9/1930

DATE
MAY 8, 1930.

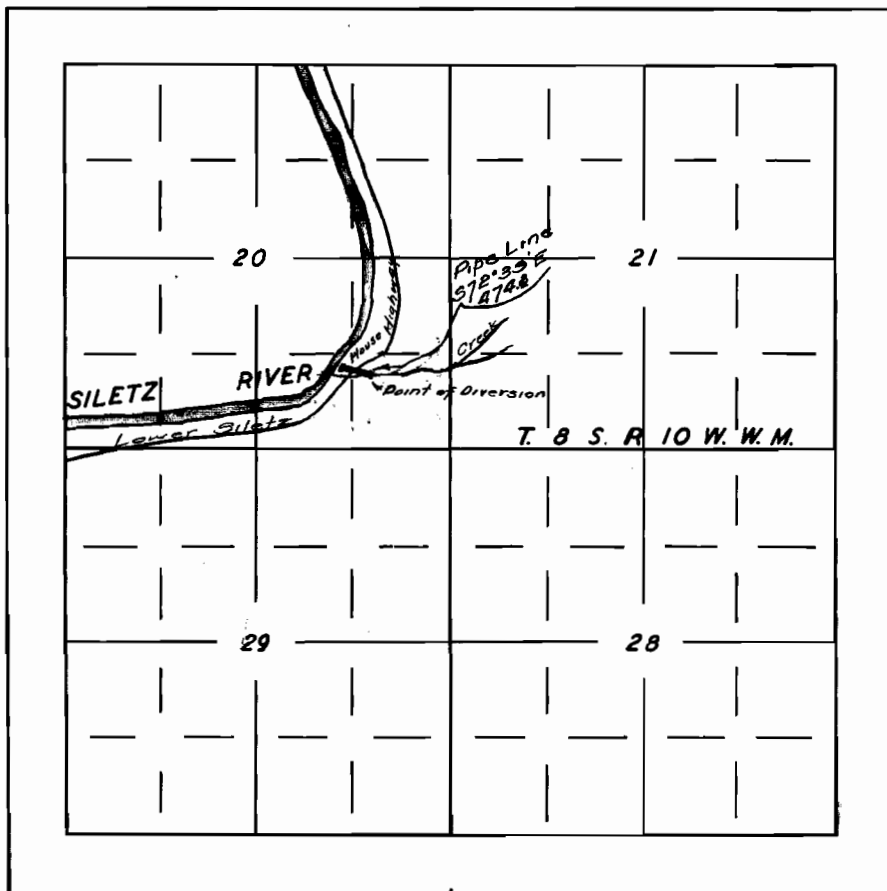

13641
9864