

SECTION

20


29

Per # 10052

9282

TOWNSHIP 10S, RANGE 31E, W. M.

North

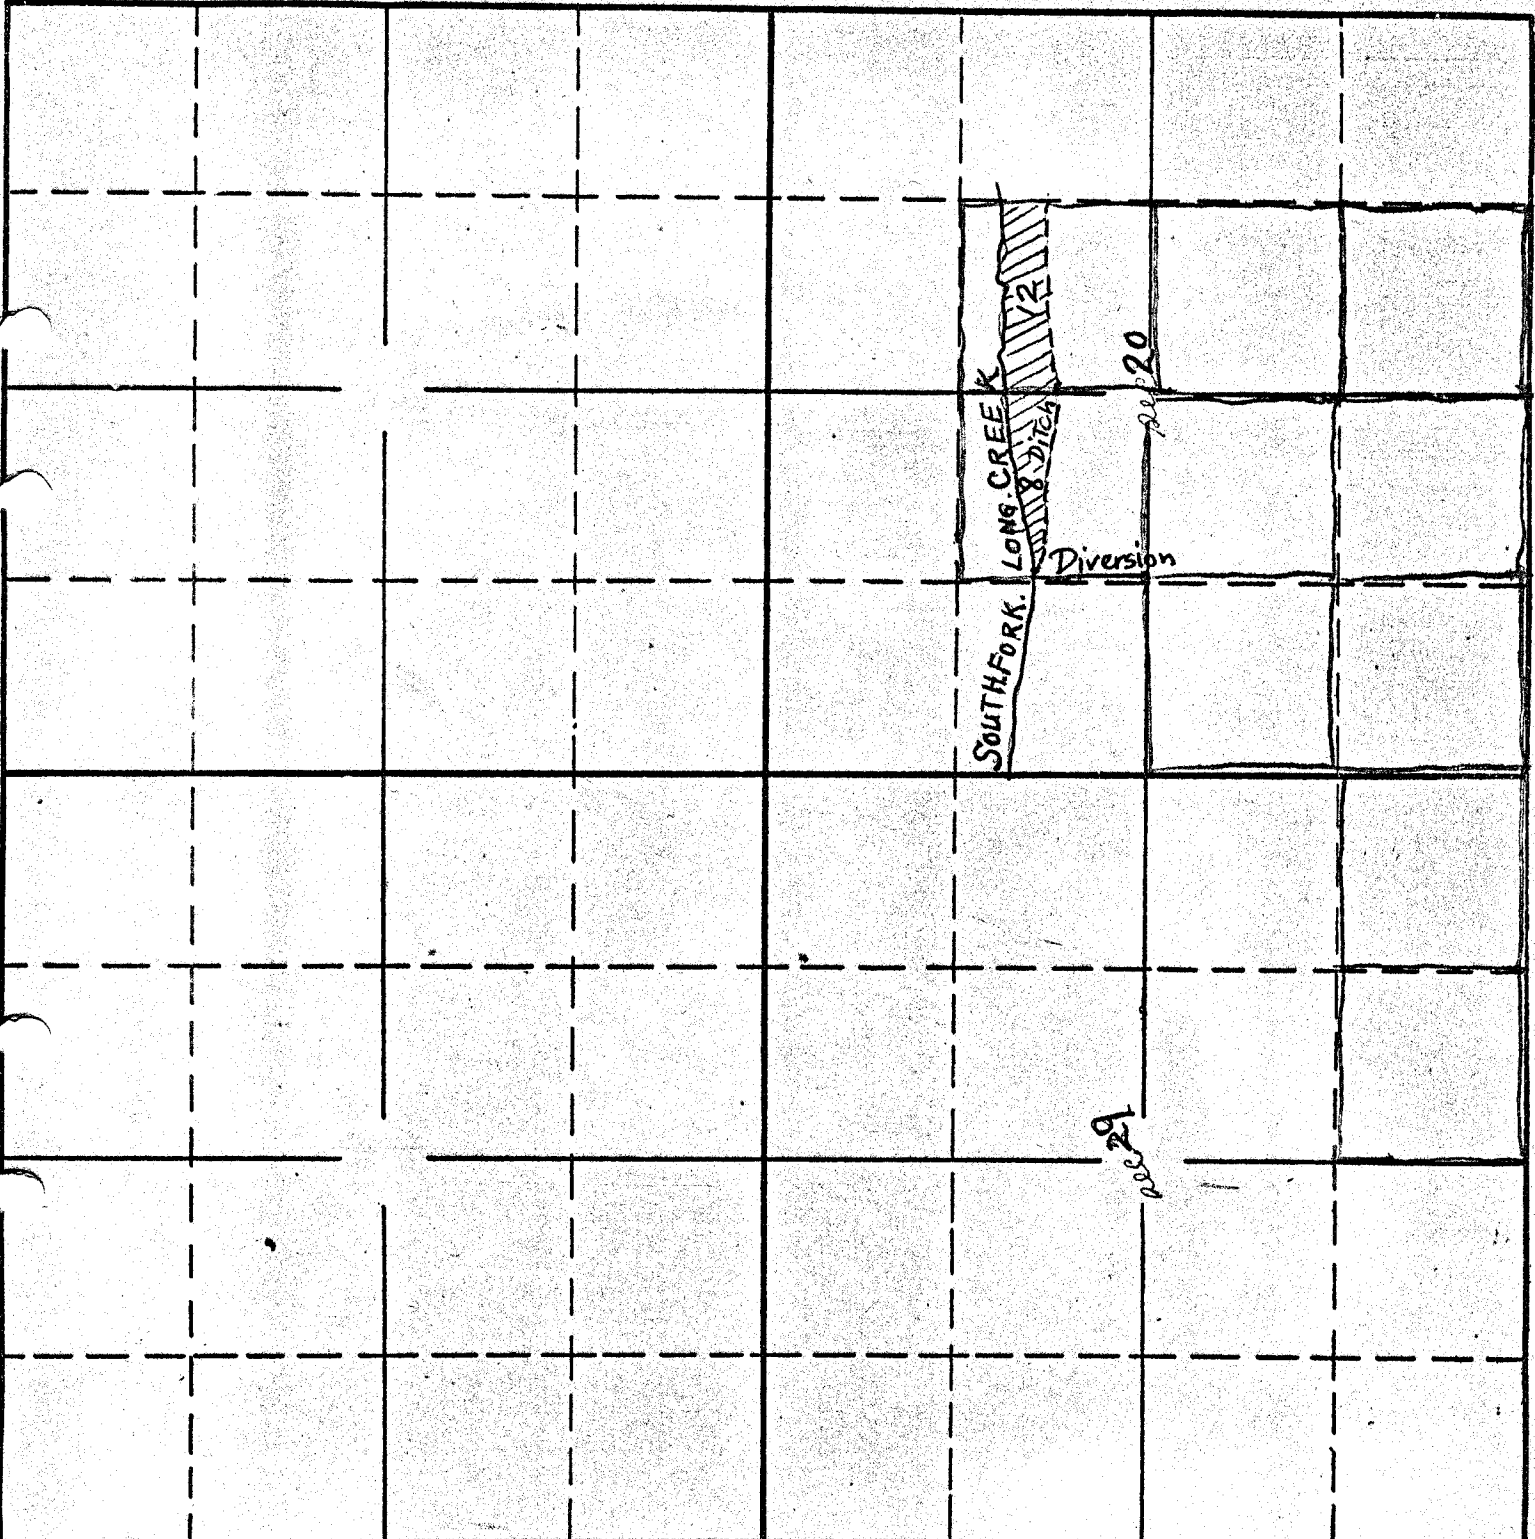

West

East

South

CIVIL ENGINEER

RECEIVED

FEB 9 1931

SALEM, OREGON

APPLICATION No. 13949
PERMIT No. 10052