
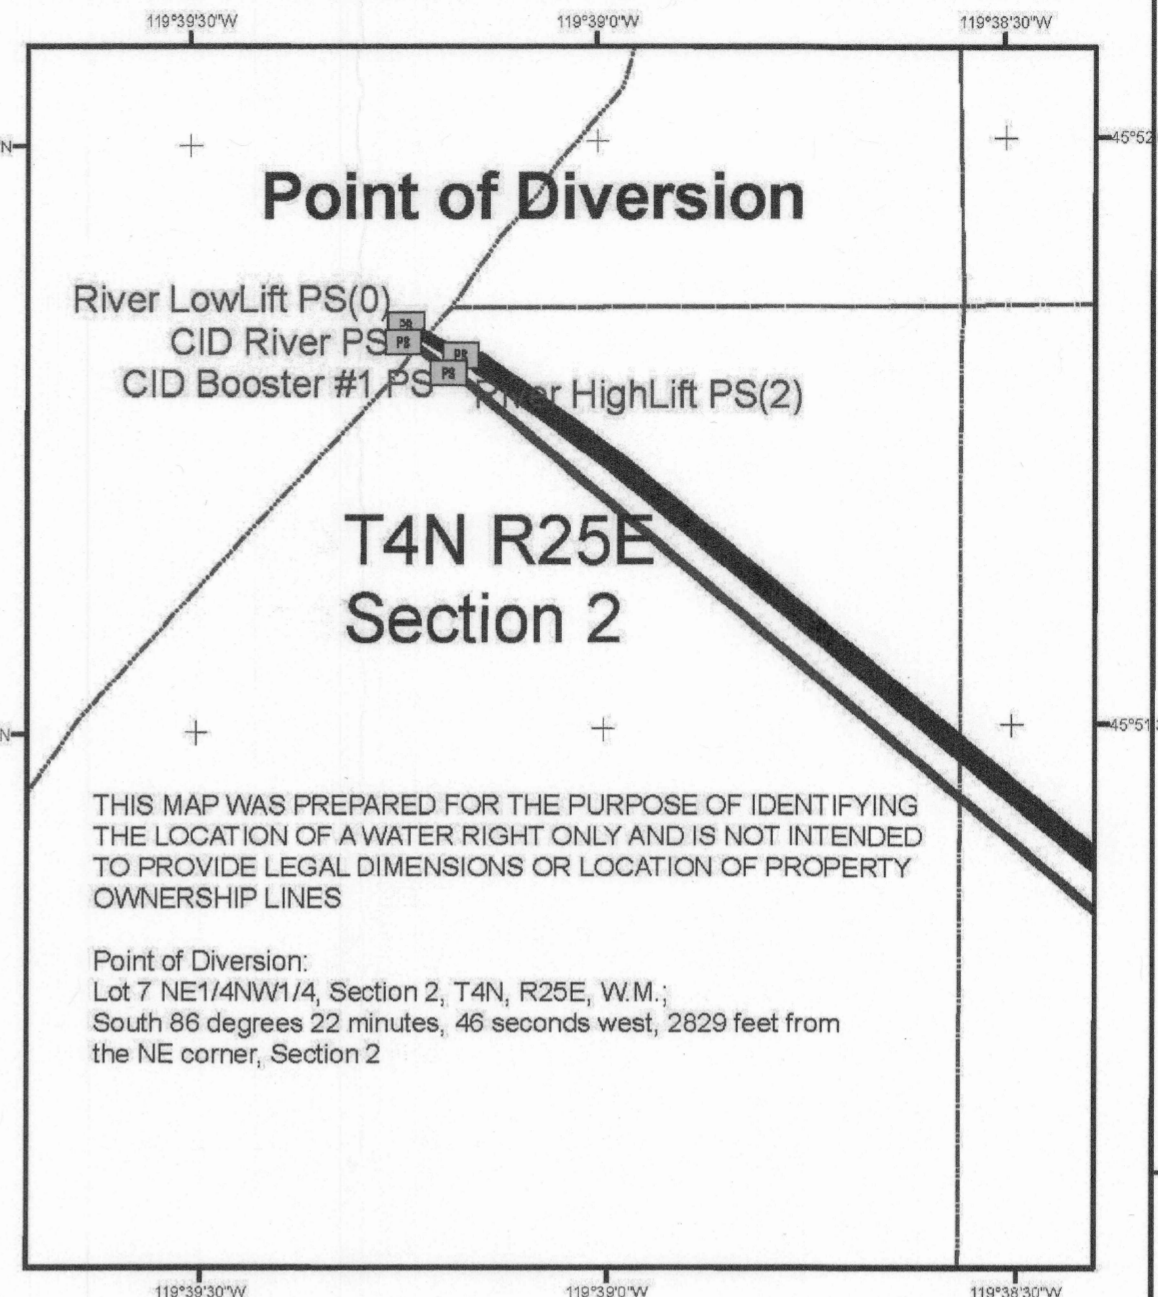


RECEIVED  
 NOV 03 2016  
 OWRD

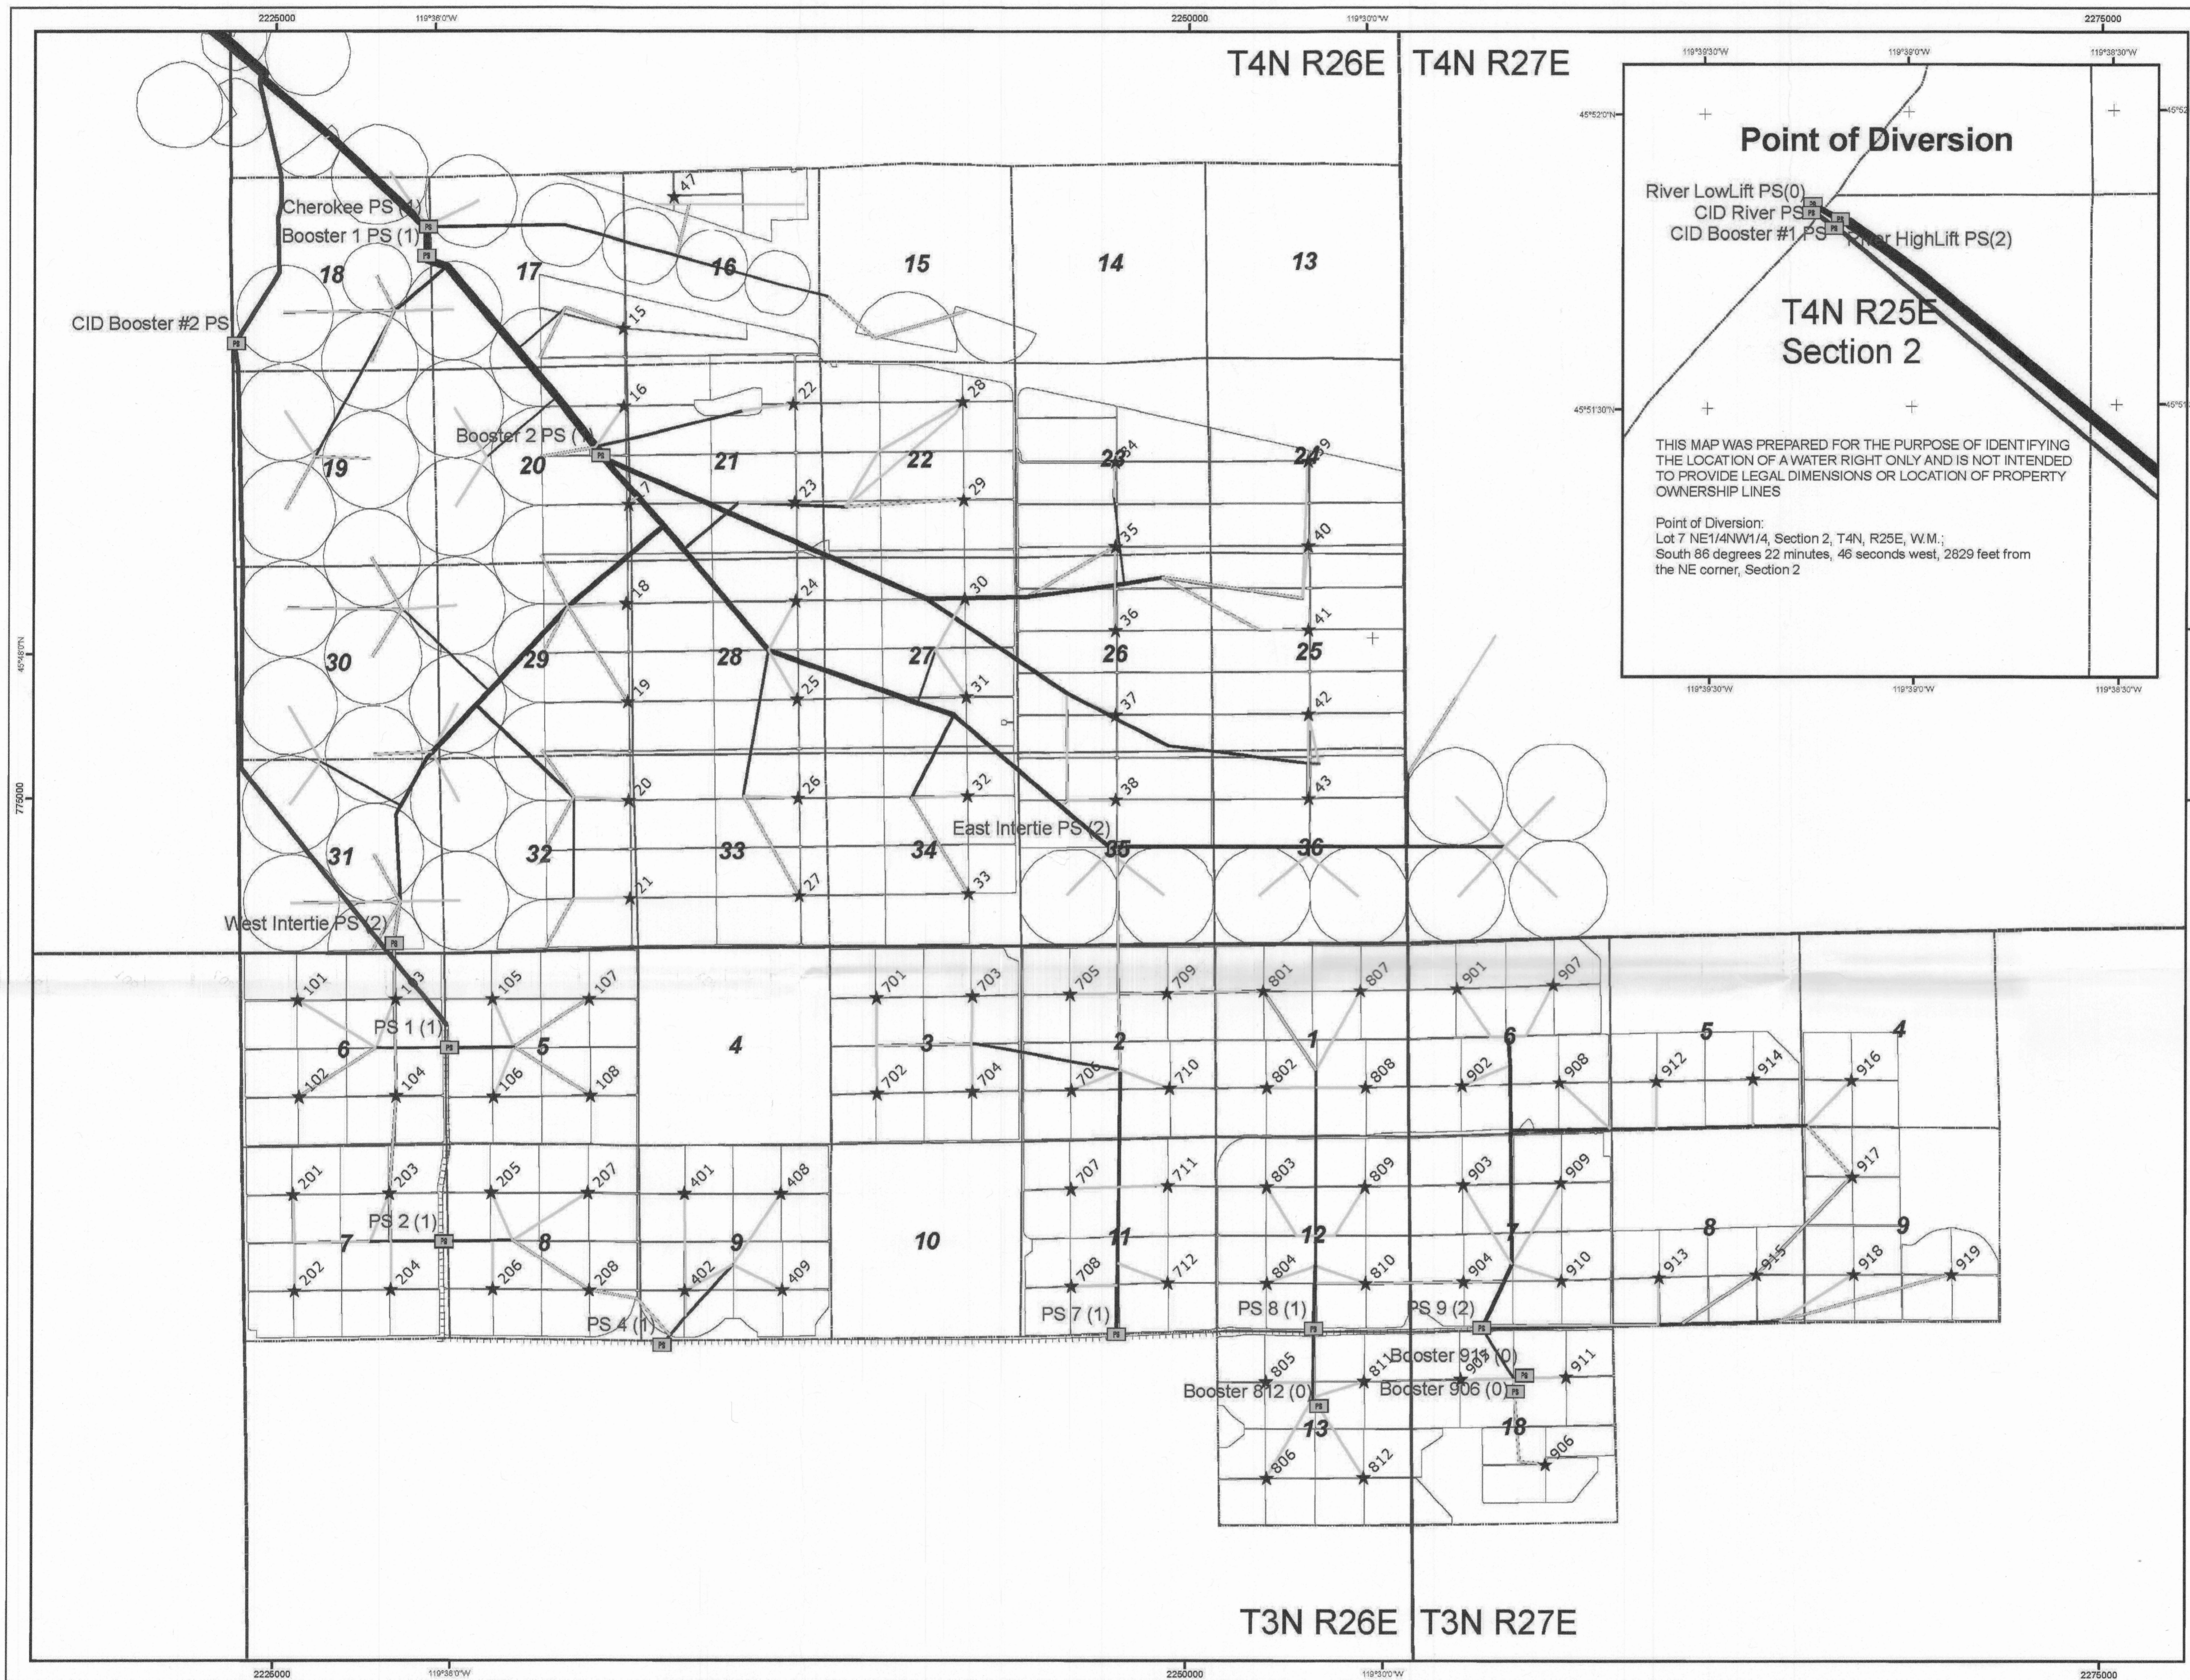

- Legend**
- Pump Station (No. of Flow Meters)
  - ★ Manifold
  - CID Canal
- Mainline Material, Dia.(in)**
- PVC, 4
  - PVC, 8
  - PVC, 10
  - PVC, 12
  - PVC, 15
  - PVC, 16
  - Steel, 12
  - Steel, 14
  - Steel, 16
  - Steel, 18
  - Steel, 20
  - Steel, 22
  - Steel, 24
  - Steel, 26
  - Steel, 30
  - Steel, 36
  - Steel, 42
  - Steel, 48
  - Steel, 54
  - Steel, 60
  - Steel, 72
- T&R
  - Section
  - circles
  - trees

Drawn By: ADB  
 OR North State Plane  
 NAD 27 (FT)  
 Date 01/05/07

N

0 0.25 0.5  
 Miles



1 inch = 0.5 miles

This map was reproduced from a Water Distribution System and Flow Meter Location map submitted to OWRD by Potlatch Corporation in 2007 for the claim of Beneficial Use on Transfer T-8753, T8675, T8616, T8298, T8617 Lands subject to these transfers were served by the same distribution system as the current transfers. This map represent the existing distribution system for the drip irrigation of trees prior to any modifications to convert the system back to irrigation with center pivots.

Water Distribution System and Flow Meter Location Map  
 Applies to Certificates 76584, 76585, 76586, 83588, 83589, 83590, 83591, 83592, and 89511  
 Farmland Reserve Inc.  
 Boardman, Oregon Farm



RECEIVED  
 NOV 03 2016  
 OWRD

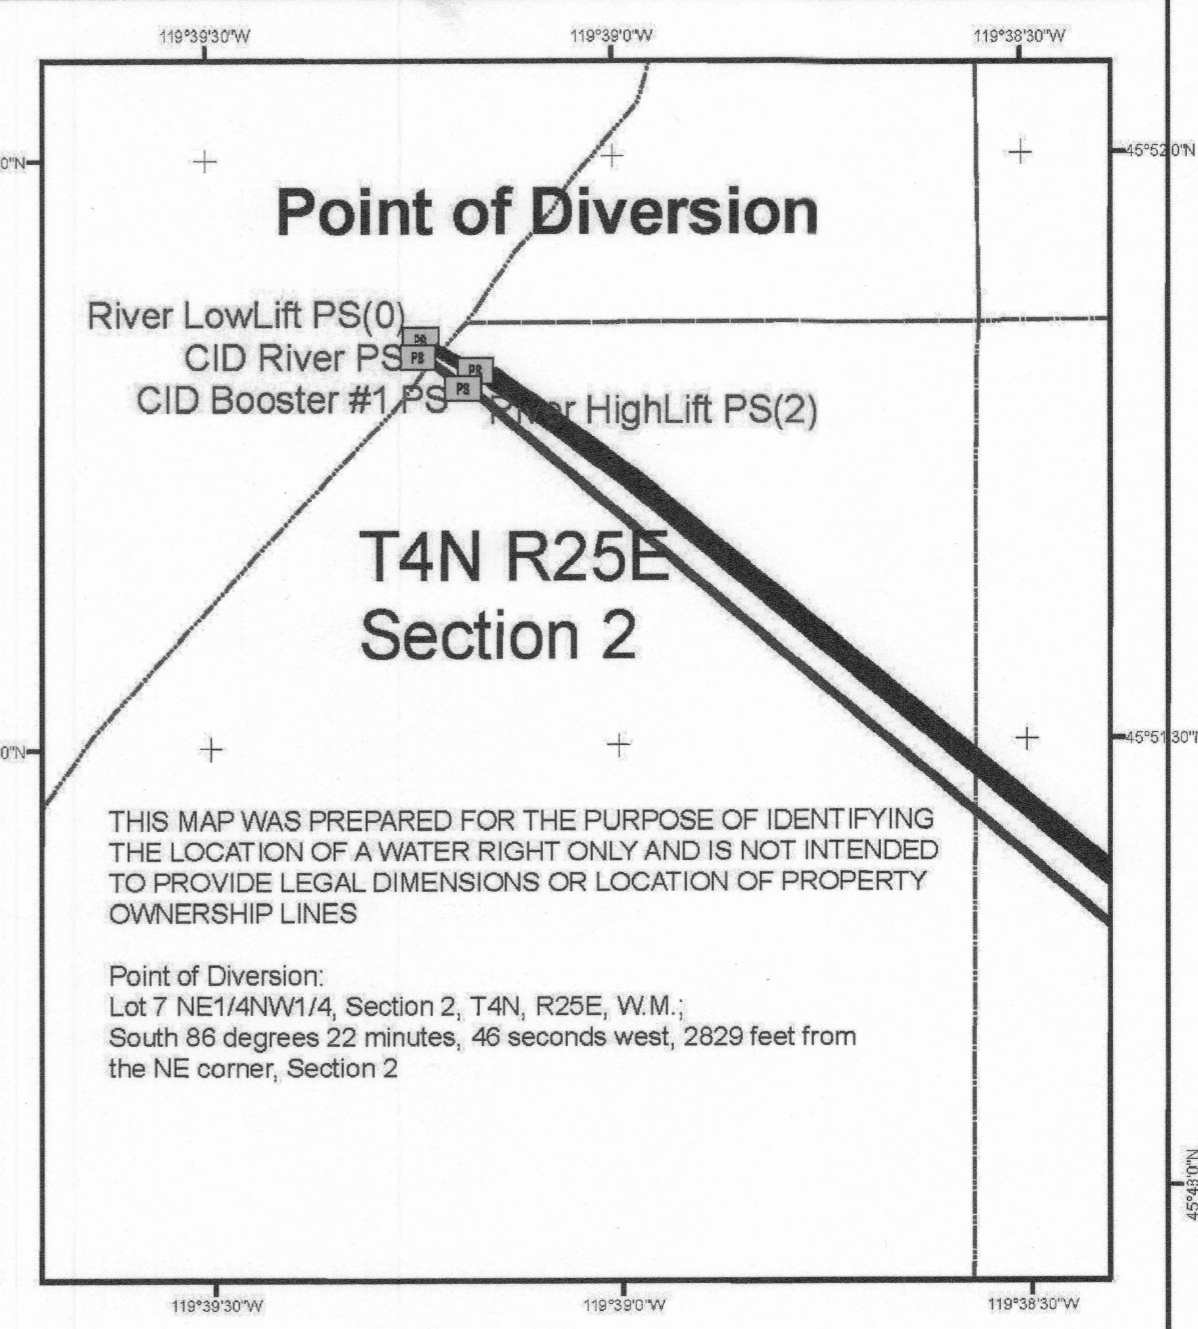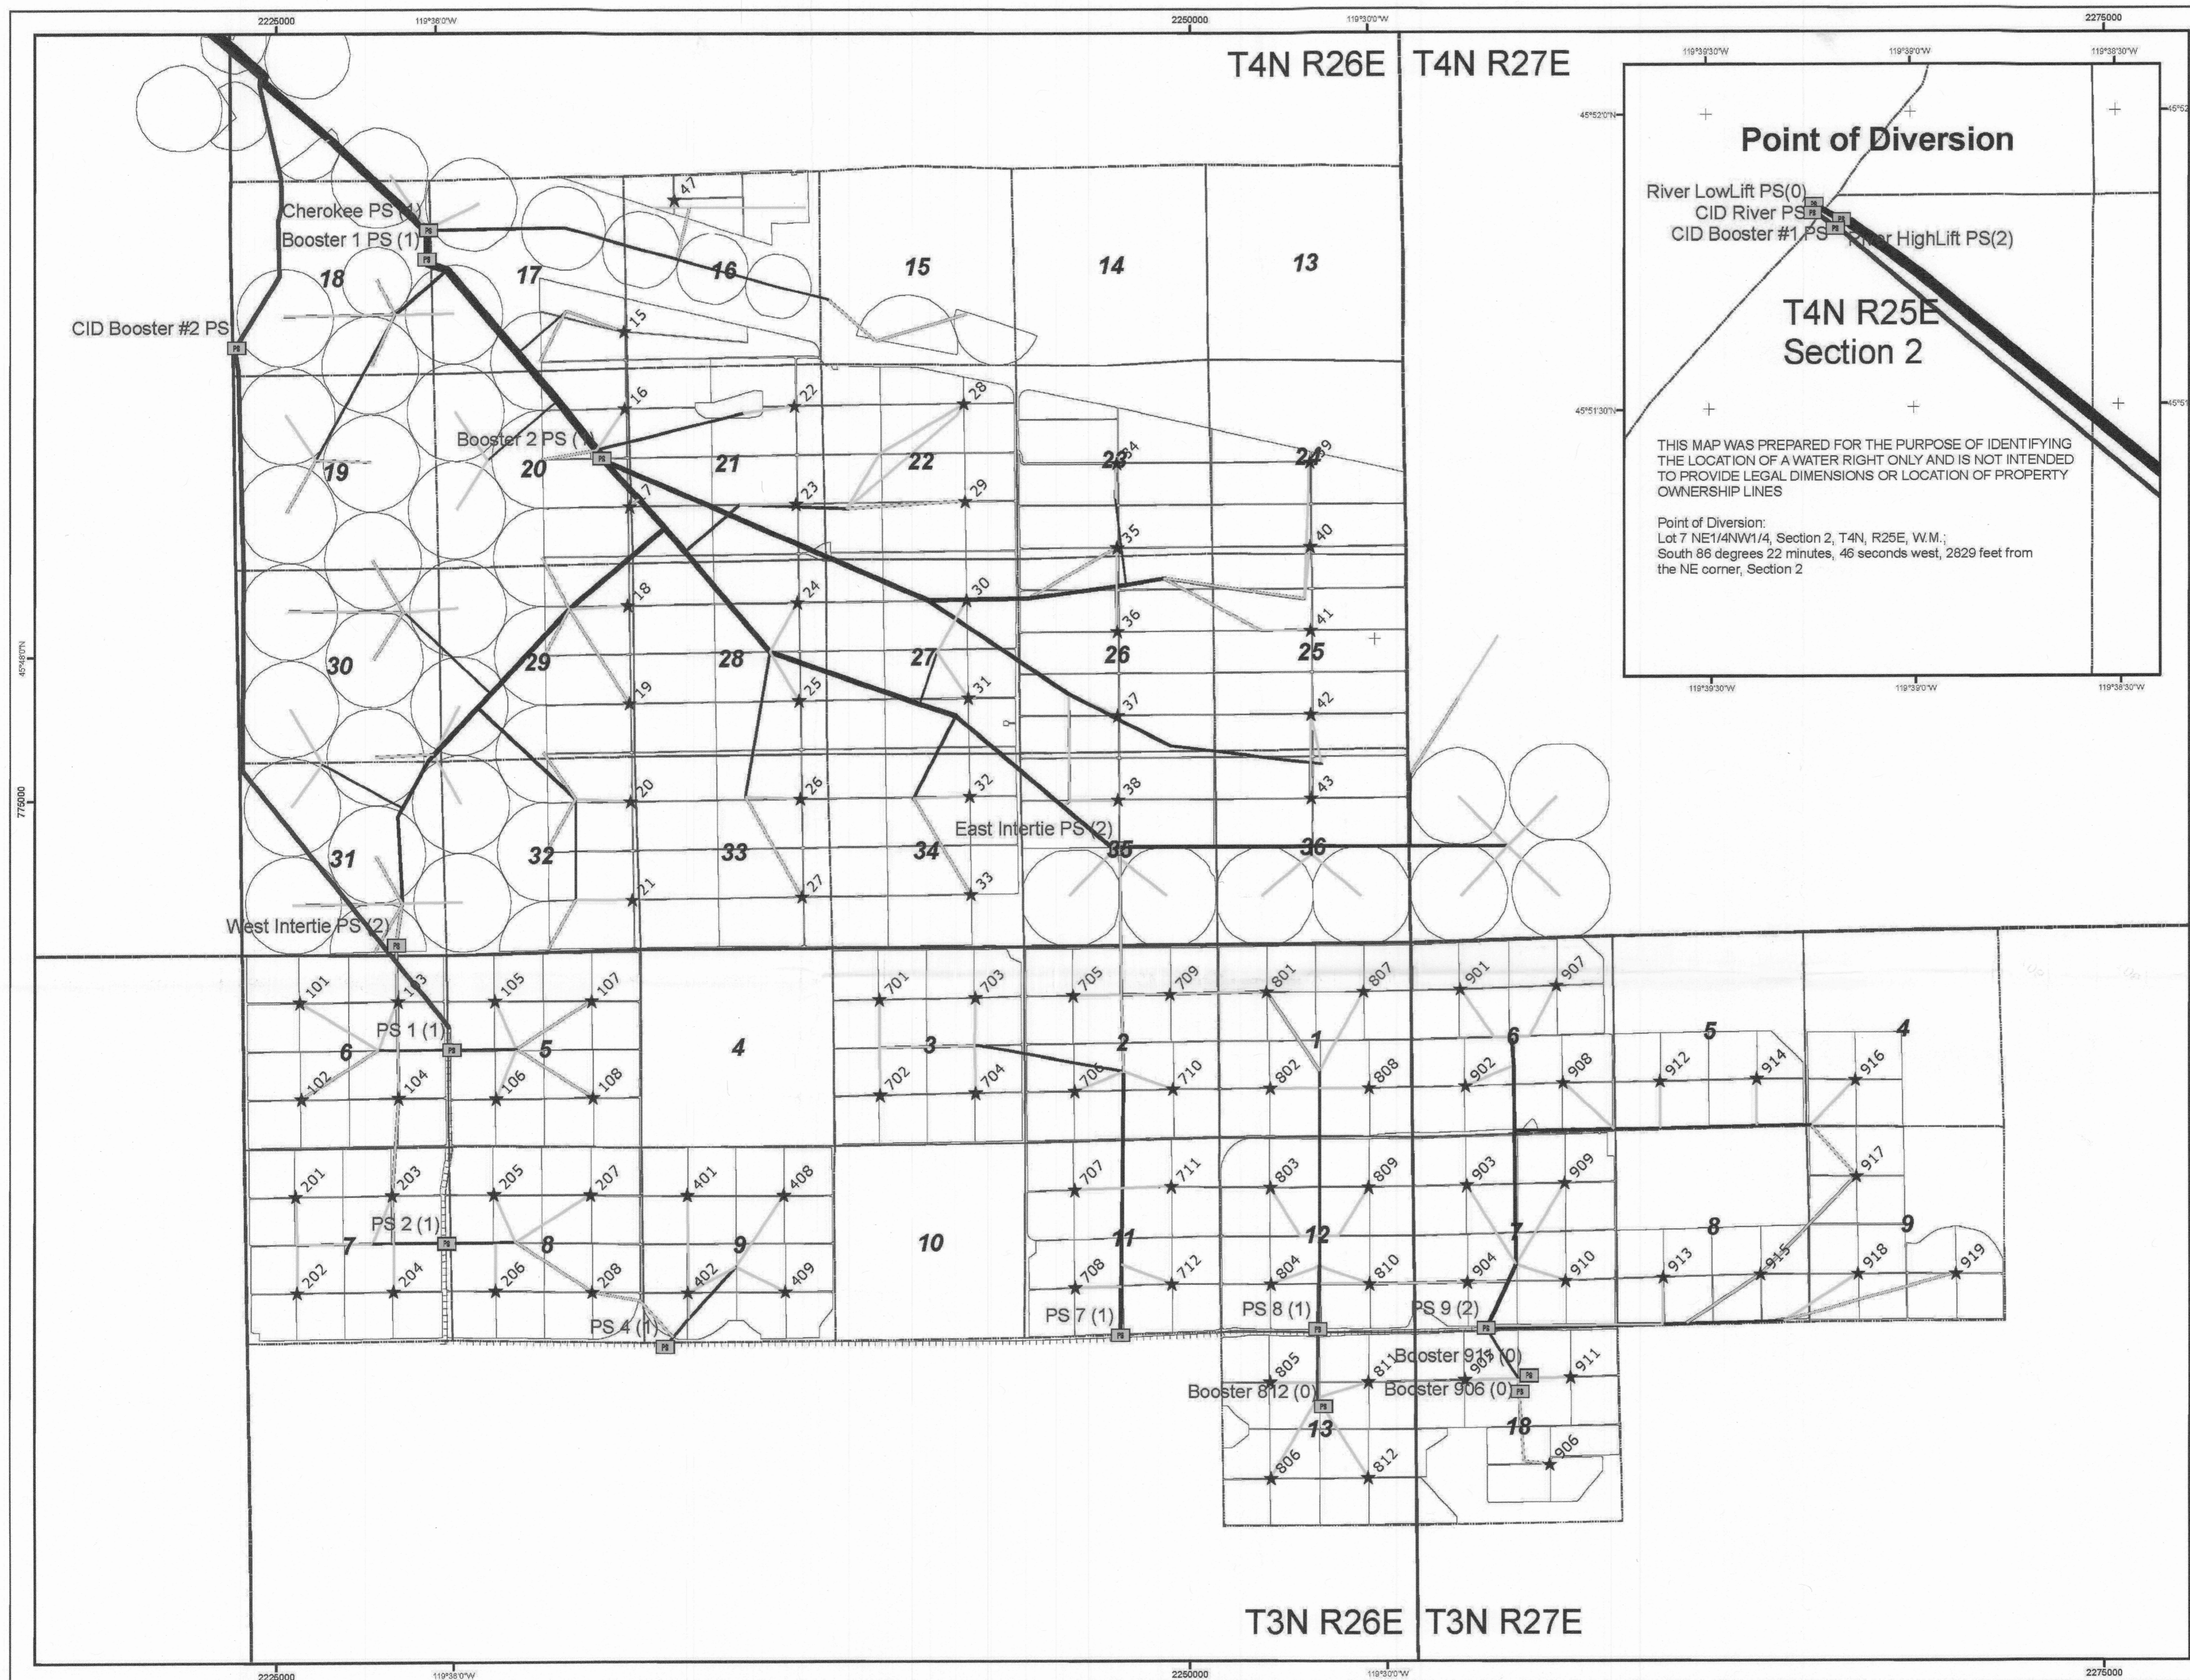

- Legend**
- Pump Station (No. of Flow Meters)
  - ★ Manifold
  - CID Canal
- Mainline Material, Dia.(in)**
- PVC, 4
  - PVC, 8
  - PVC, 10
  - PVC, 12
  - PVC, 15
  - PVC, 16
  - Steel, 12
  - Steel, 14
  - Steel, 16
  - Steel, 18
  - Steel, 20
  - Steel, 22
  - Steel, 24
  - Steel, 26
  - Steel, 30
  - Steel, 36
  - Steel, 42
  - Steel, 48
  - Steel, 54
  - Steel, 60
  - Steel, 72
- T&R
  - Section
  - circles
  - trees


Drawn By: ADB  
 OR North State Plane  
 NAD 27 (FT)  
 Date 01/05/07

This map was reproduced from a Water Distribution System and Flow Meter Location map submitted to OWRD by Potlatch Corporation in 2007 for the claim of Beneficial Use on Transfer T-8753, T8675, T8616, T8298, T8617 Lands subject to these transfers were served by the same distribution system as the current transfers. This map represent the existing distribution system for the drip irrigation of trees prior to any modifications to convert the system back to irrigation with center pivots.

**Water Distribution System and Flow Meter Location Map**  
 Applies to Certificates 76584, 76585, 76586, 83588, 83589, 83590, 83591, 83592, and 89511  
 Fairland Reserve Inc.  
 Boardman, Oregon Farm



TOWNSHIP 3 NORTH, RANGE 26 & 27 EAST, W. M.

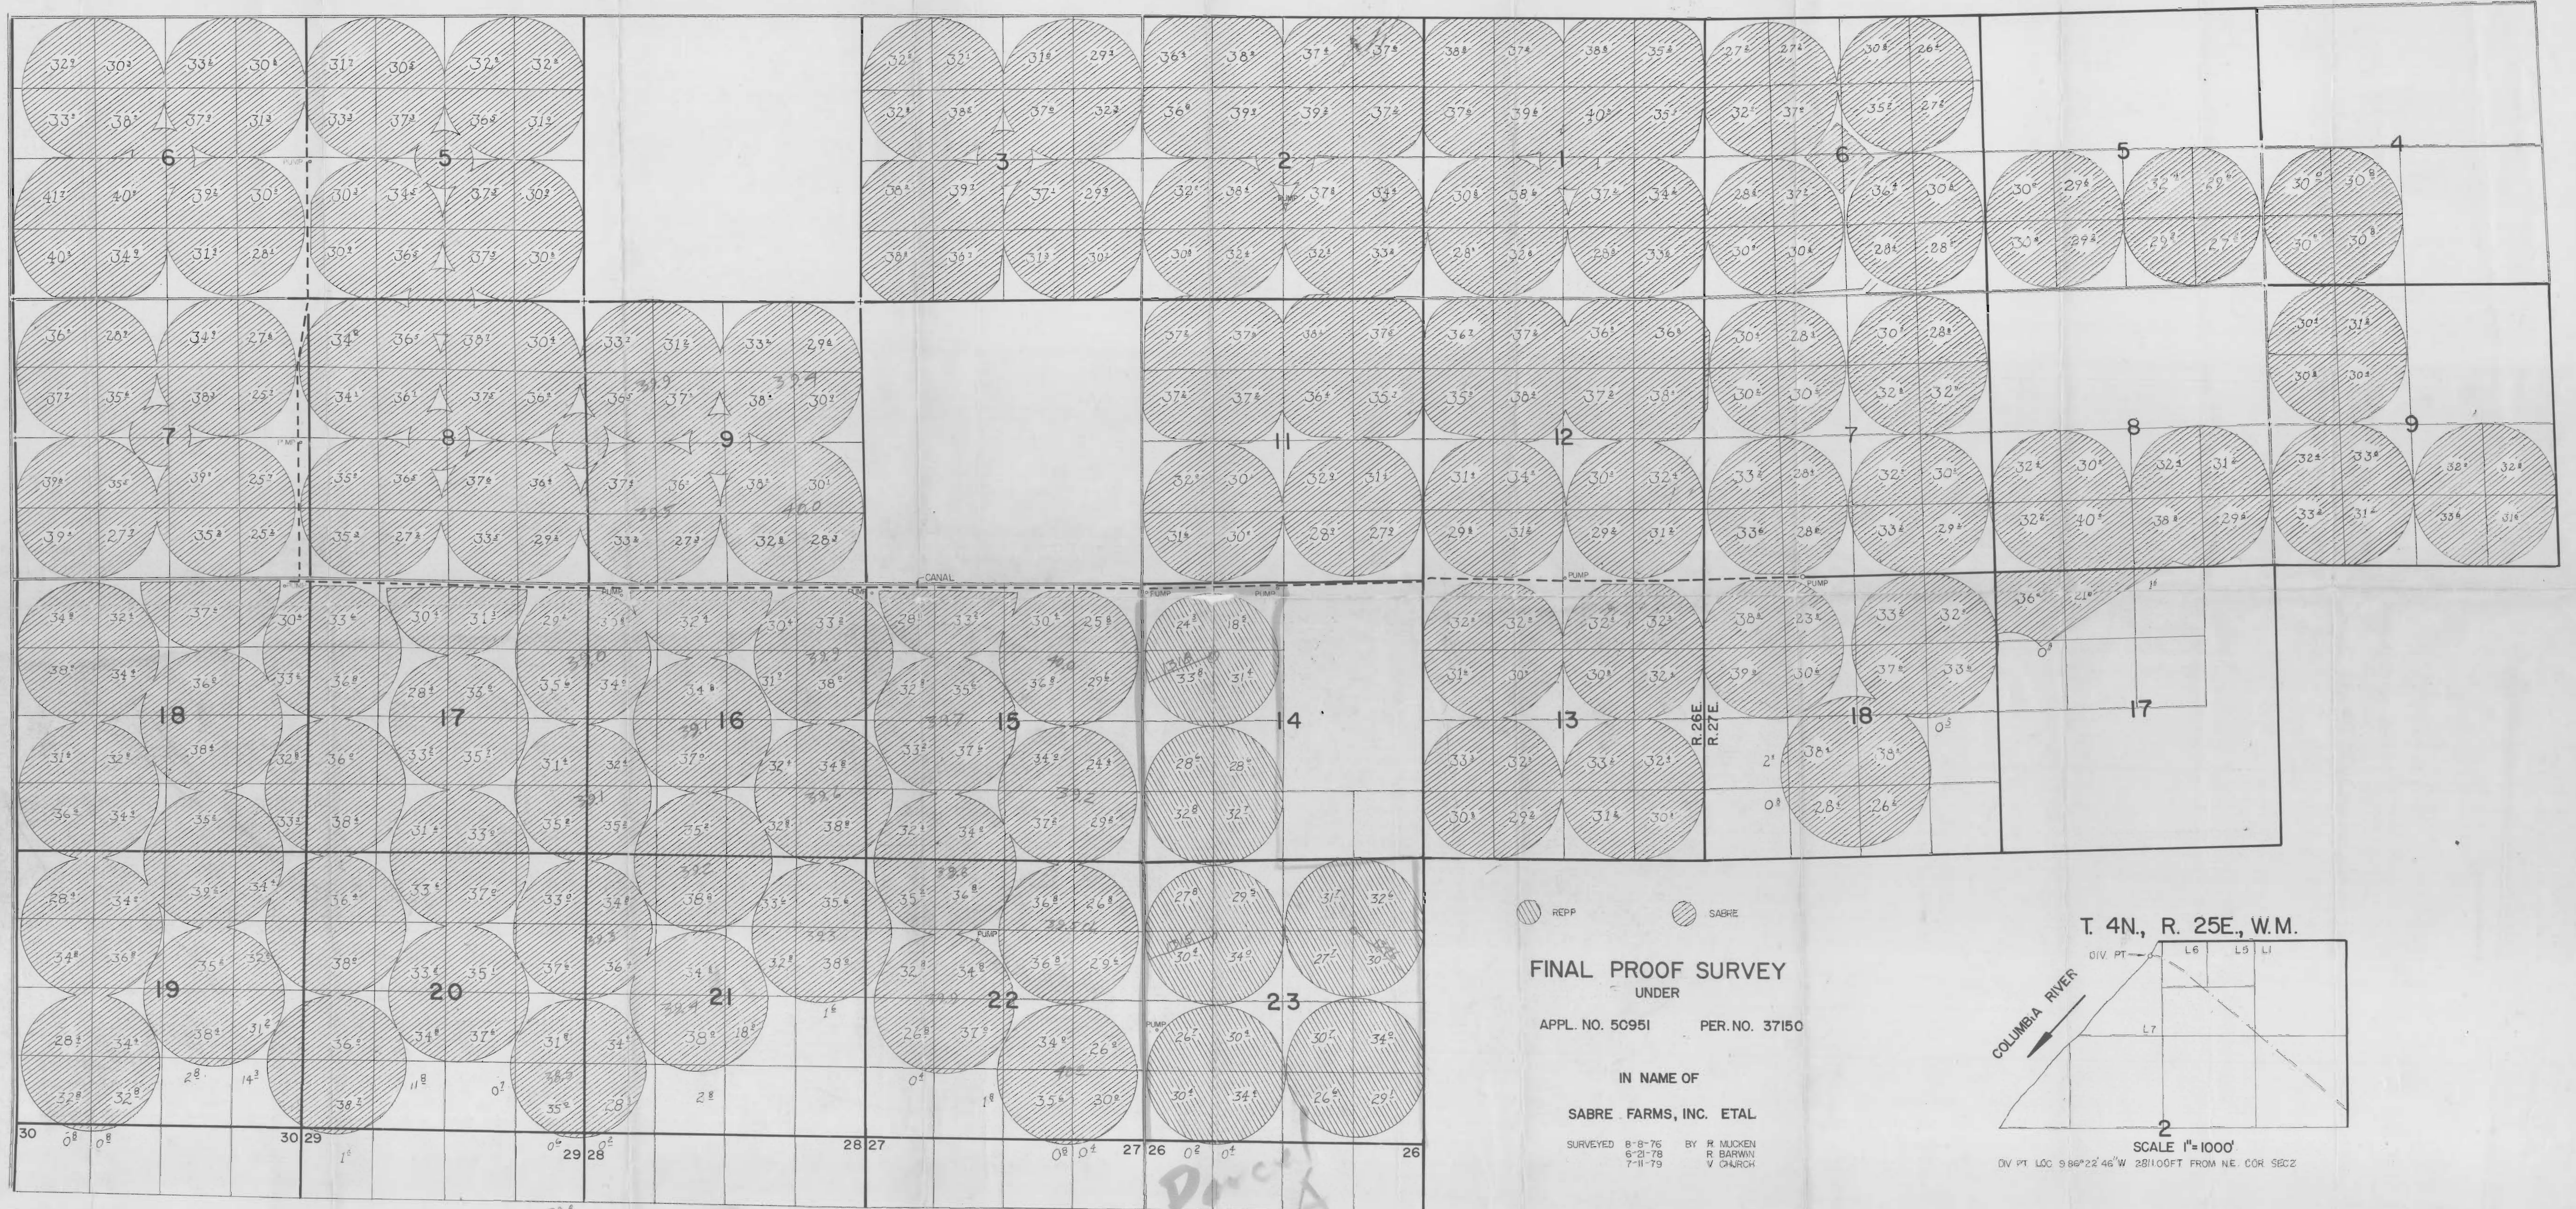

REPP SABRE


**FINAL PROOF SURVEY**  
UNDER

APPL. NO. 50951 PER. NO. 37150

IN NAME OF

**SABRE FARMS, INC. ETAL**

SURVEYED 8-8-76 BY R. MUCKEN  
6-21-78 R. BARWIN  
7-11-79 V. CHURCH

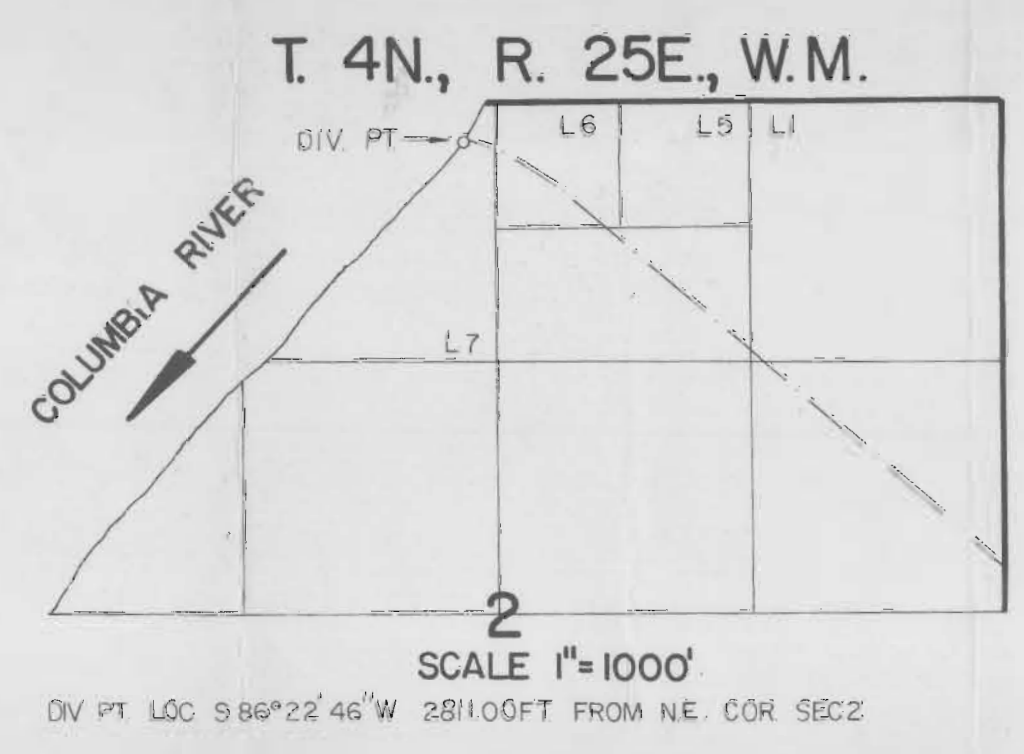




RECEIVED  
NOV 03 2016



- LEGEND**
- FRI Property Boundary
  - Water Bodies
  - From Lands (Existing POU Associated with this Transfer)
  - Railroads
  - Lands Left Unchanged (Remaining Right)
  - Pipelines
  - PLSS Sections
  - Paved Roads

SESE Quarter Quarter Section Location and Water Right POU Acres

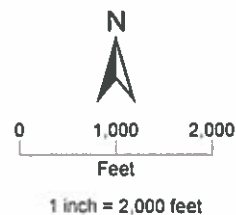

This drawing is an exhibit for a Water Right Permanent Transfer. This map is not intended to provide legal dimensions or locations of property ownership lines. Property lines and/or other lines of occupation shown hereon are not represented by the undersigned to meet accuracy standards of Land Surveys.

CWRE: Jason Smesrud  
 Drawn By: Edward Douglas  
 Date: October 2016  
 Projection: NAD83 Oregon Statewide Lambert, International Feet



EXPIRATION DATE: 6/30/2018

Existing Place of Use (POU) Map  
 Permanent Water Rights Transfer  
 Certificate 76585  
 Farmland Reserve Inc.  
 Boardman, Oregon Farm  
 T3N, R26E, WM and T3N, R27E, WM  
 Morrow County, Oregon

The POU consists of 8 foot wide irrigated strips located on 10 foot centers marked by the tree rows