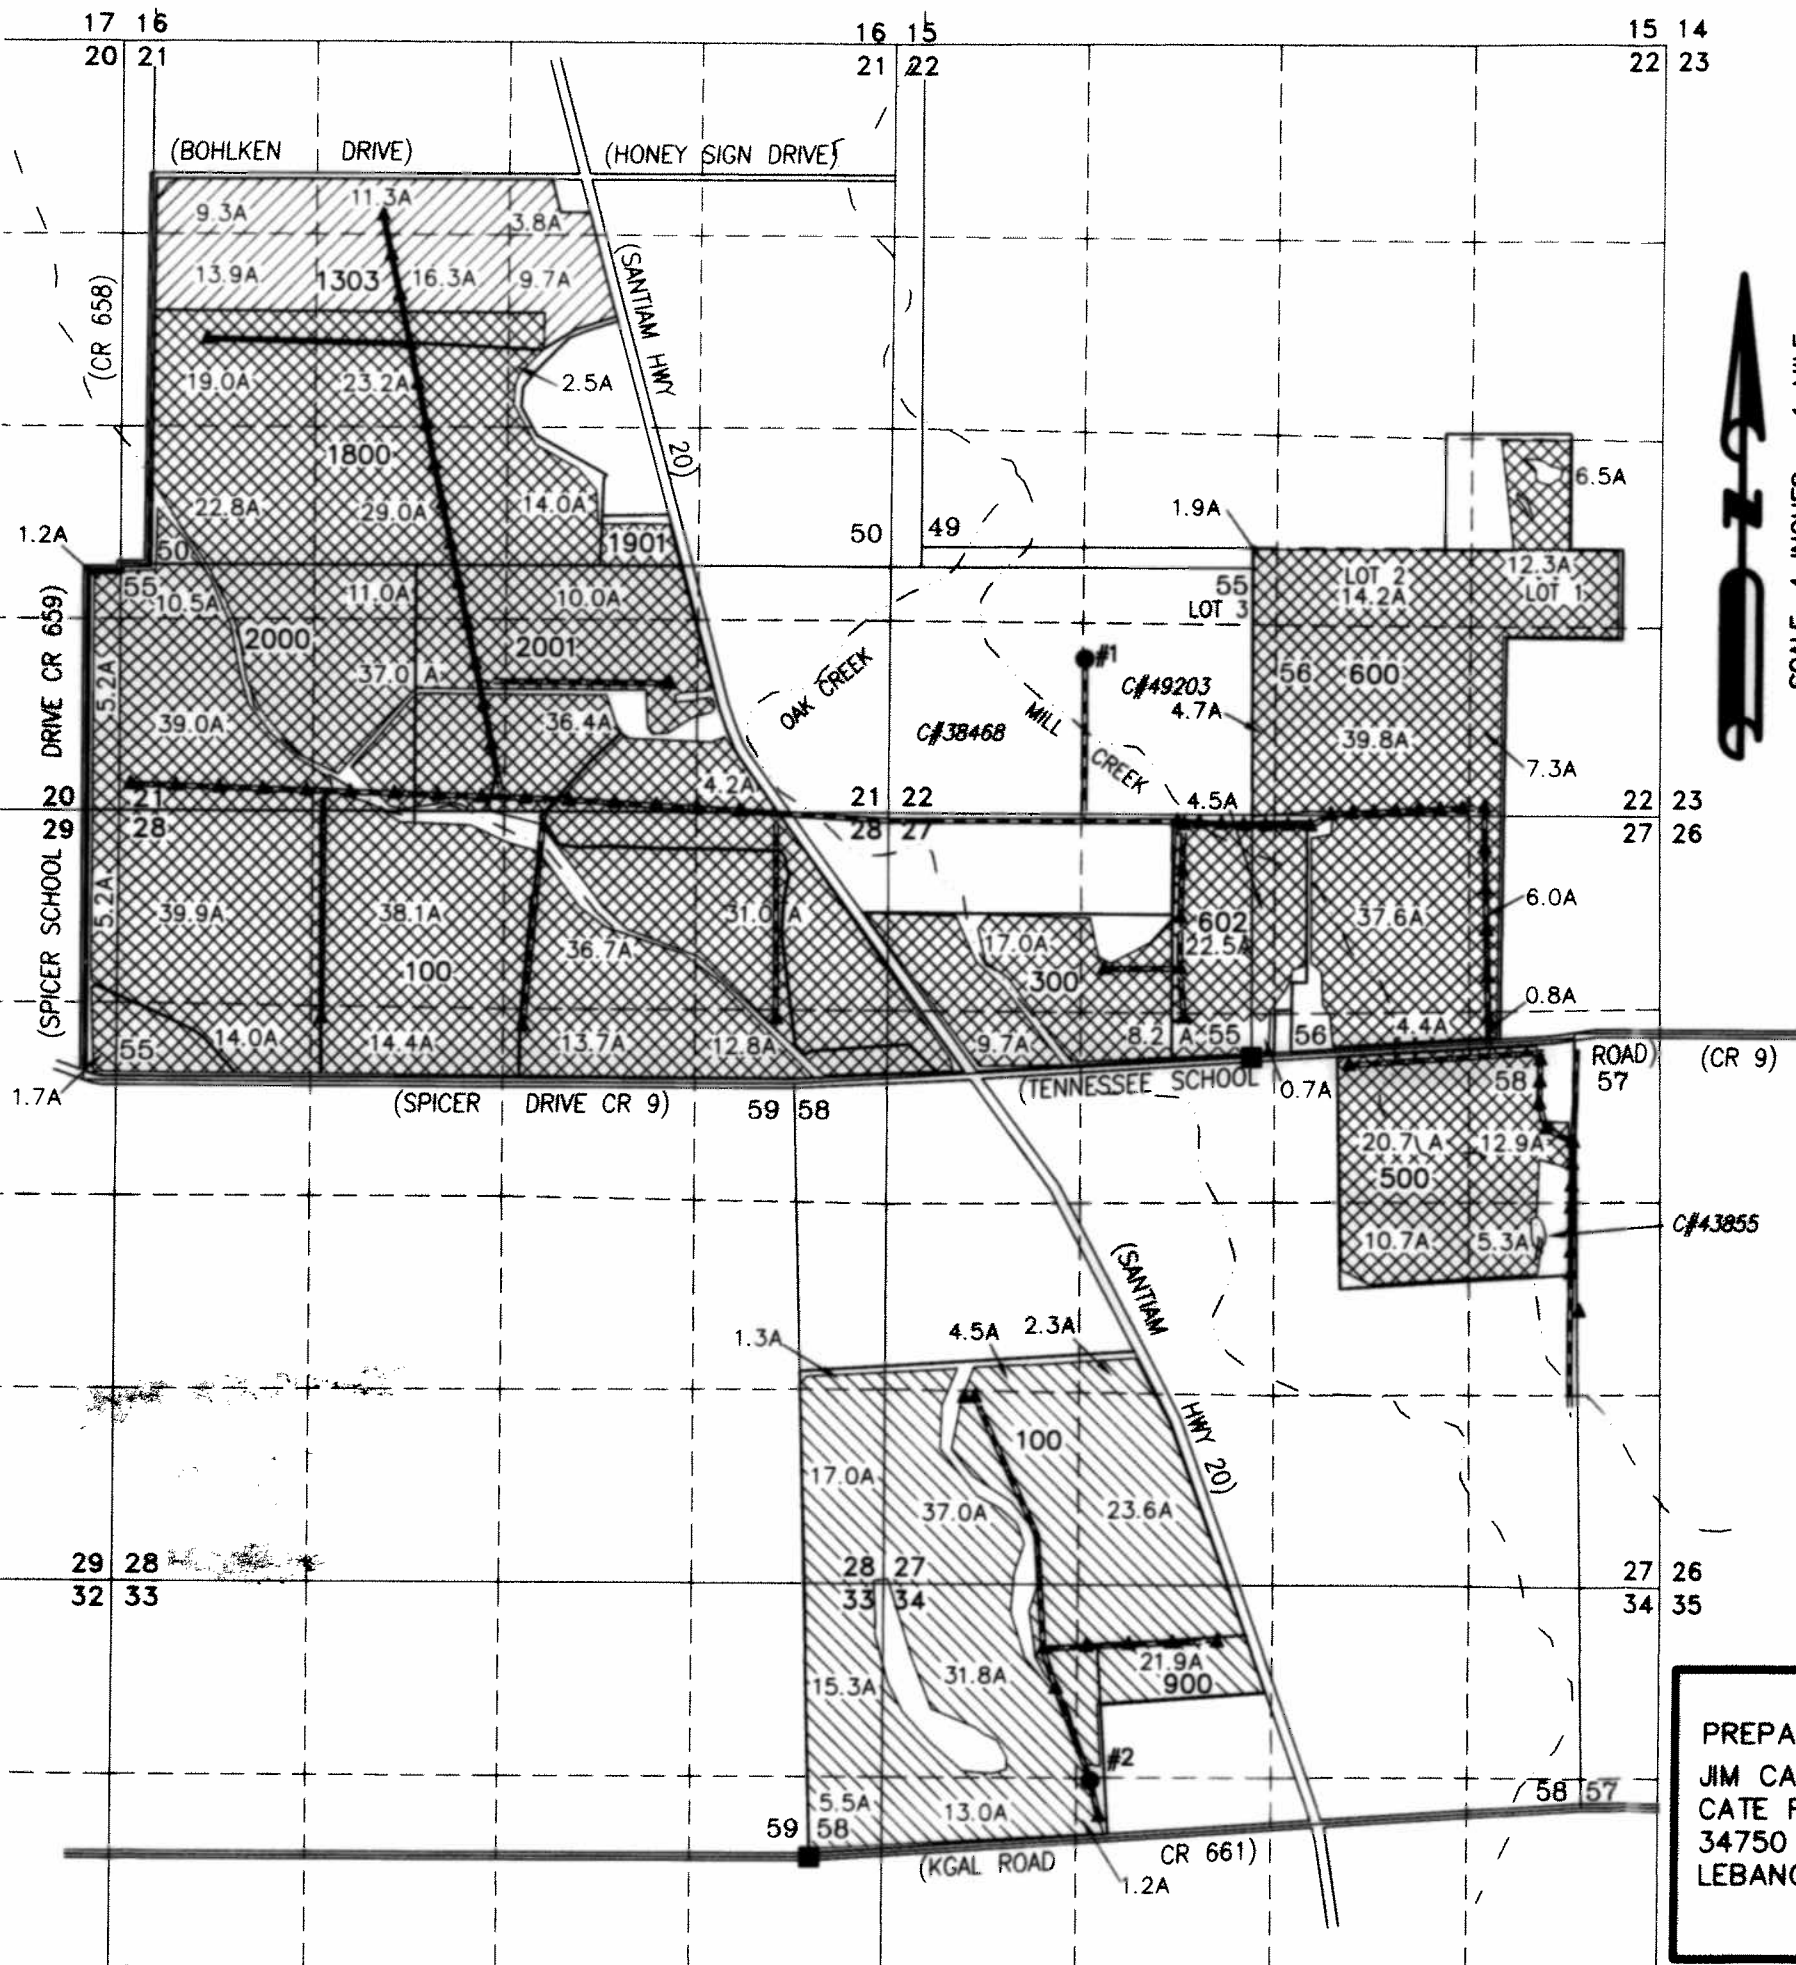


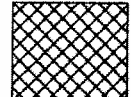
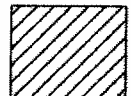

FINAL PROOF MAP








TO SHOW WATER RIGHTS AND
POINTS OF APPROPRIATION
FOR APPLICATIONS G-16167 G-16168, AND G-16846
JIM CATE, CATE FARMS

TOWNSHIP 11 SOUTH, RANGE 2 WEST, SECTIONS 20, 21, 22, 27, 28, 29, 33, & 34, W.M.
TAX LOTS: 100, 300, 500, 600, 602, 900, 1303, 1800, AND 1901
ALL IN LINN COUNTY, OREGON

SCALE: 4 INCHES = 1 MILE



-  720.2 ACRES PRIMARY IRRIGATION FROM G-16028, AS SHOWN
-  64.3 ACRES PRIMARY IRRIGATION FROM G-16340, AS SHOWN
-  174.4 ACRES PRIMARY IRRIGATION FROM G-15963, AS SHOWN

-  12-INCH PVC PIPE
-  10-INCH PVC PIPE
-  8-INCH PVC PIPE
-  STREAM
-  D.L.C. LINE
-  HYDRANT/RISER
-  DLC MONUMENT TIED

- 40.0A = 40.0 ACRES IRRIGATION
- #1
WELL #1 (LINN 57038)
PERMITS: G-18028 AND G-16340
1132.2' NORTH & 1651.4' EAST FROM THE SW CORNER SECTION 22
METER IS LOCATED ON PIPE 6' NW OF WELL
- #2
WELL #2 (LINN 57546)
PERMIT: G-15963
1274.86' SOUTH & 1434.31' EAST FROM THE NW CORNER SECTION 34
METER IS LOCATED ON PIPE 8' SOUTH OF WELL




RENEWAL DATE: 12/31/2018

THIS MAP IS FOR THE PURPOSE OF LOCATING A WATER RIGHT ONLY AND HAS NO INTENT TO PROVIDE LEGAL DIMENSIONS OR THE LOCATION OF PROPERTY LINES

RECEIVED BY OWBD

MAR 02 2017

SALEM, OR

<p>PREPARED FOR: JIM CATE CATE FARMS 34750 SOUTH SANTIAM HWY LEBANON, OR 97355</p>	<p>PREPARED BY:  ALL POINTS ENGINEERING AND SURVEYING, INC. P.O. BOX 767 (CRR) TERREBONNE, OR 97760 (541) 548-5833 www.APEandS.com</p>
--	---