


T. 7S., R. 38E., W.M.

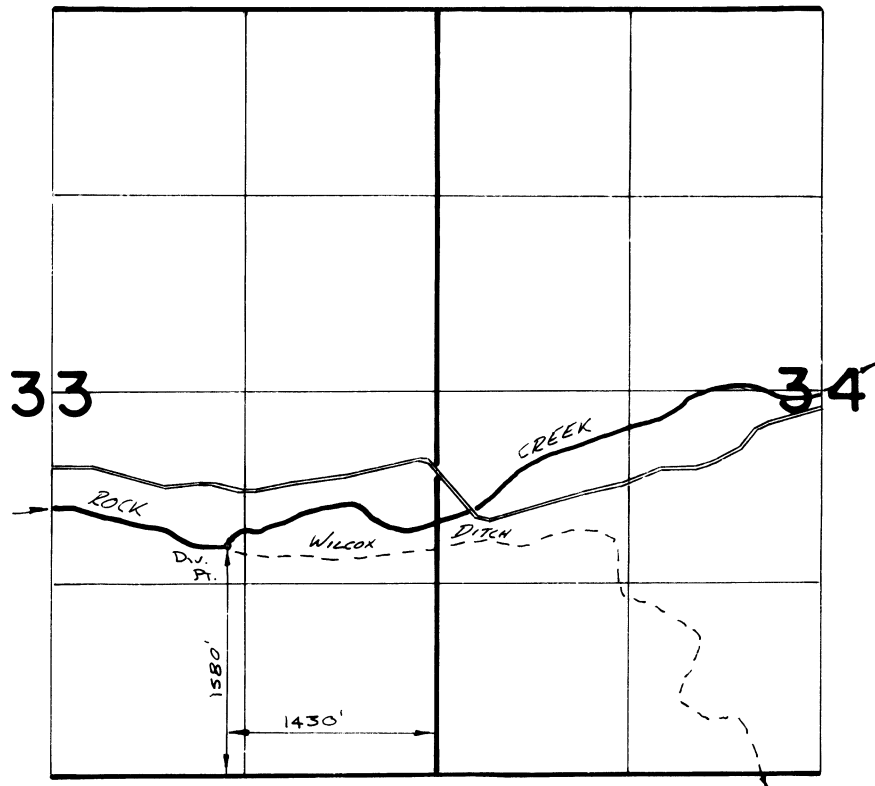

FINAL PROOF SURVEY
UNDER


TRANSFER 3000

IN NAME OF

.....JAMES...E.....KERNS.....

Surveyed ...4-13..... 1982, by *E. L. Church*

Township 8 South, Range 38 East.

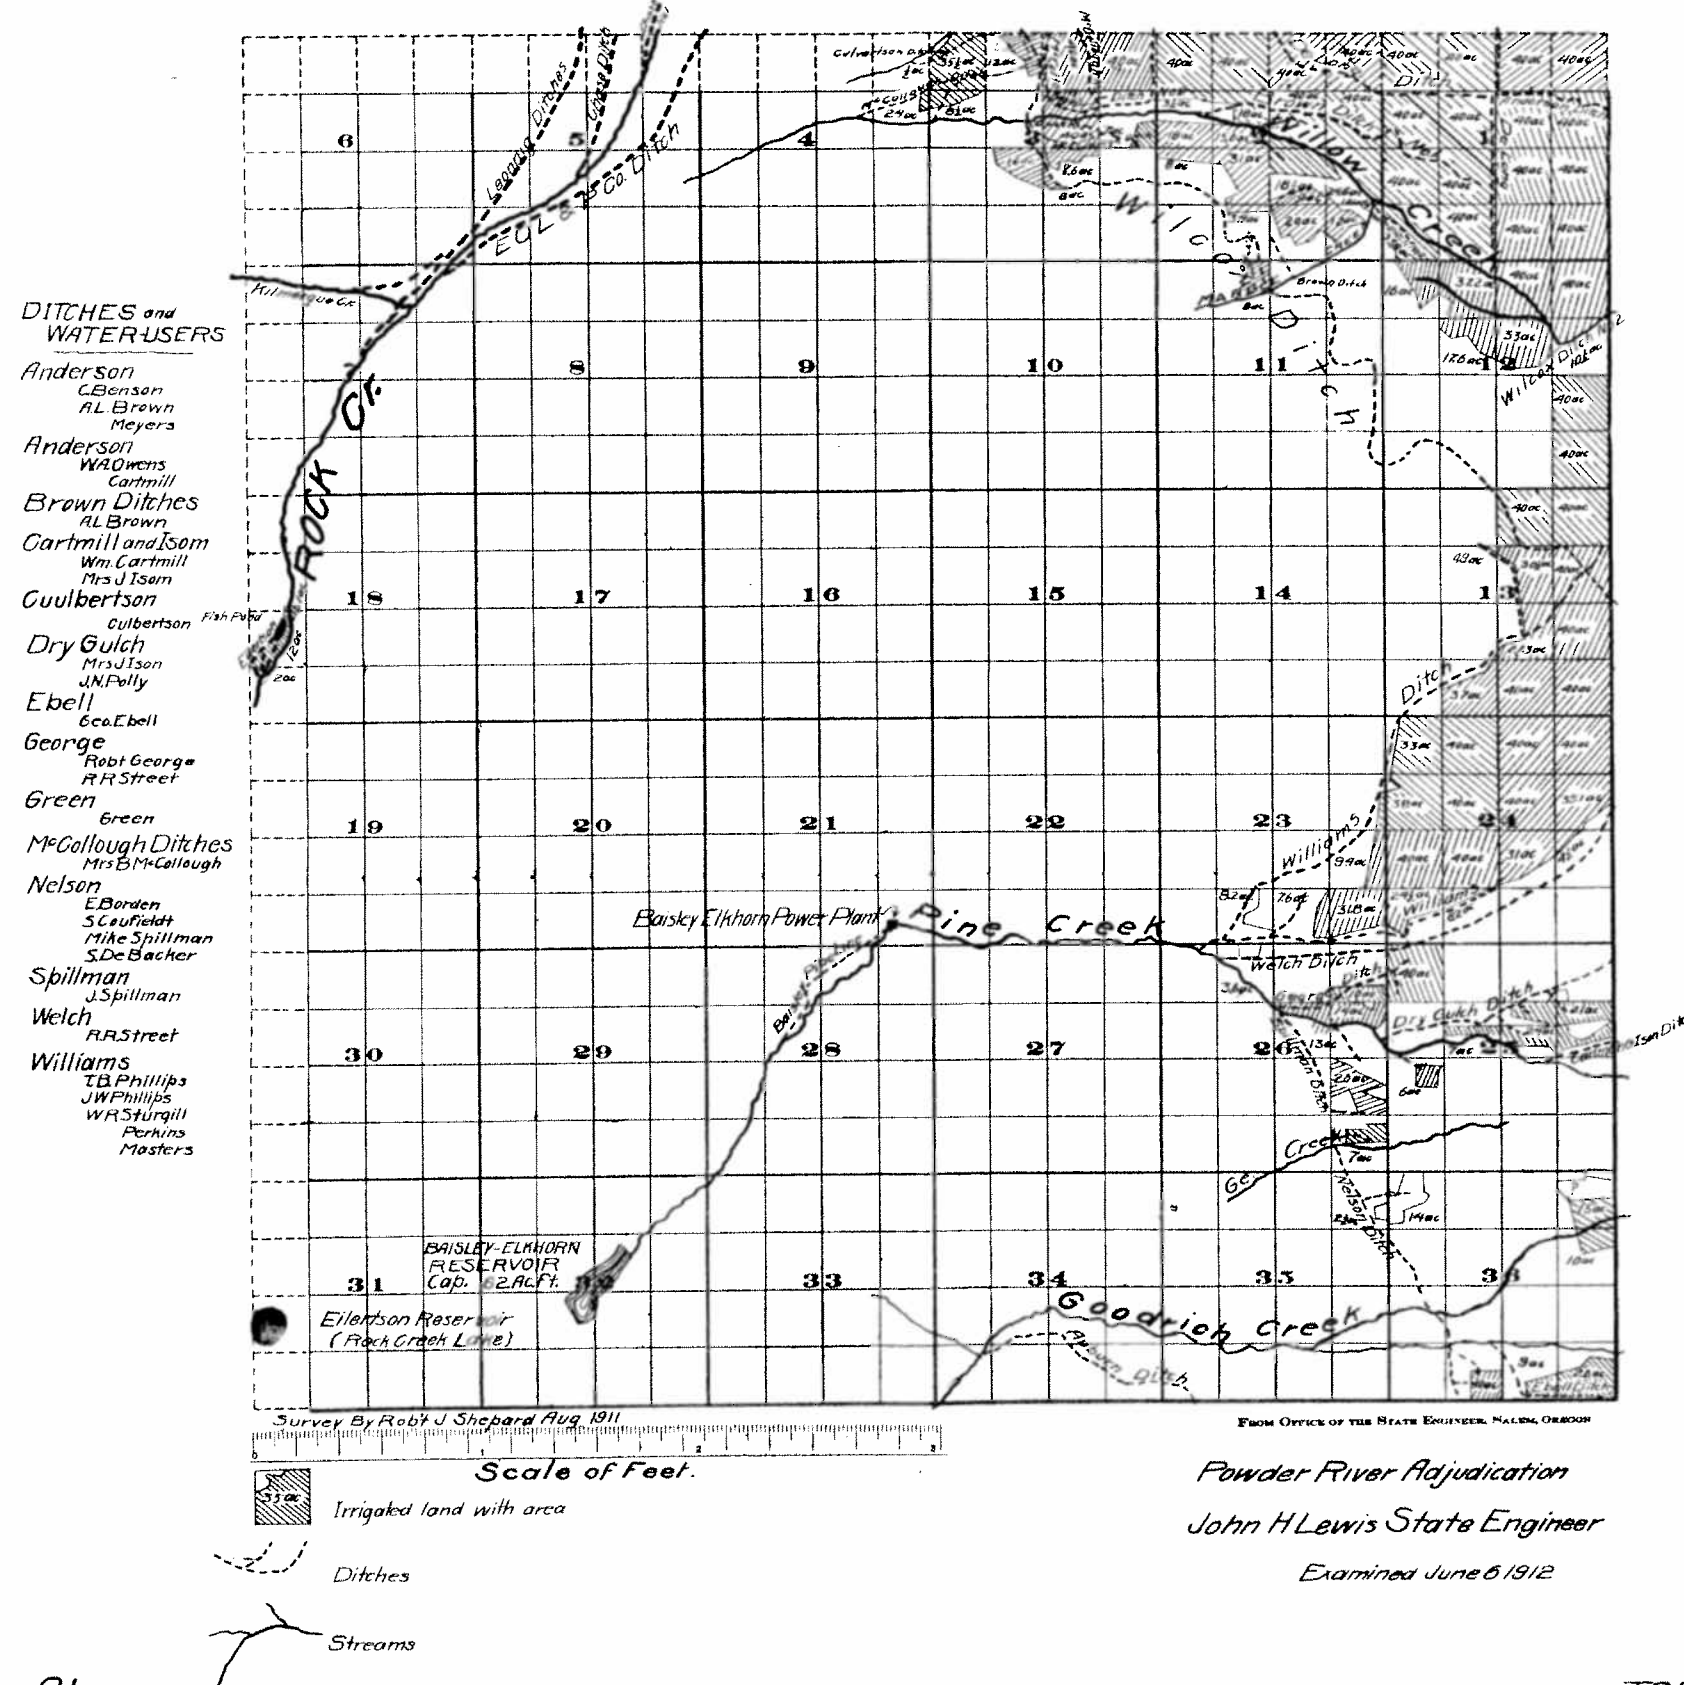

Powder River Adjudication
John H Lewis State Engineer
Examined June 6 1912