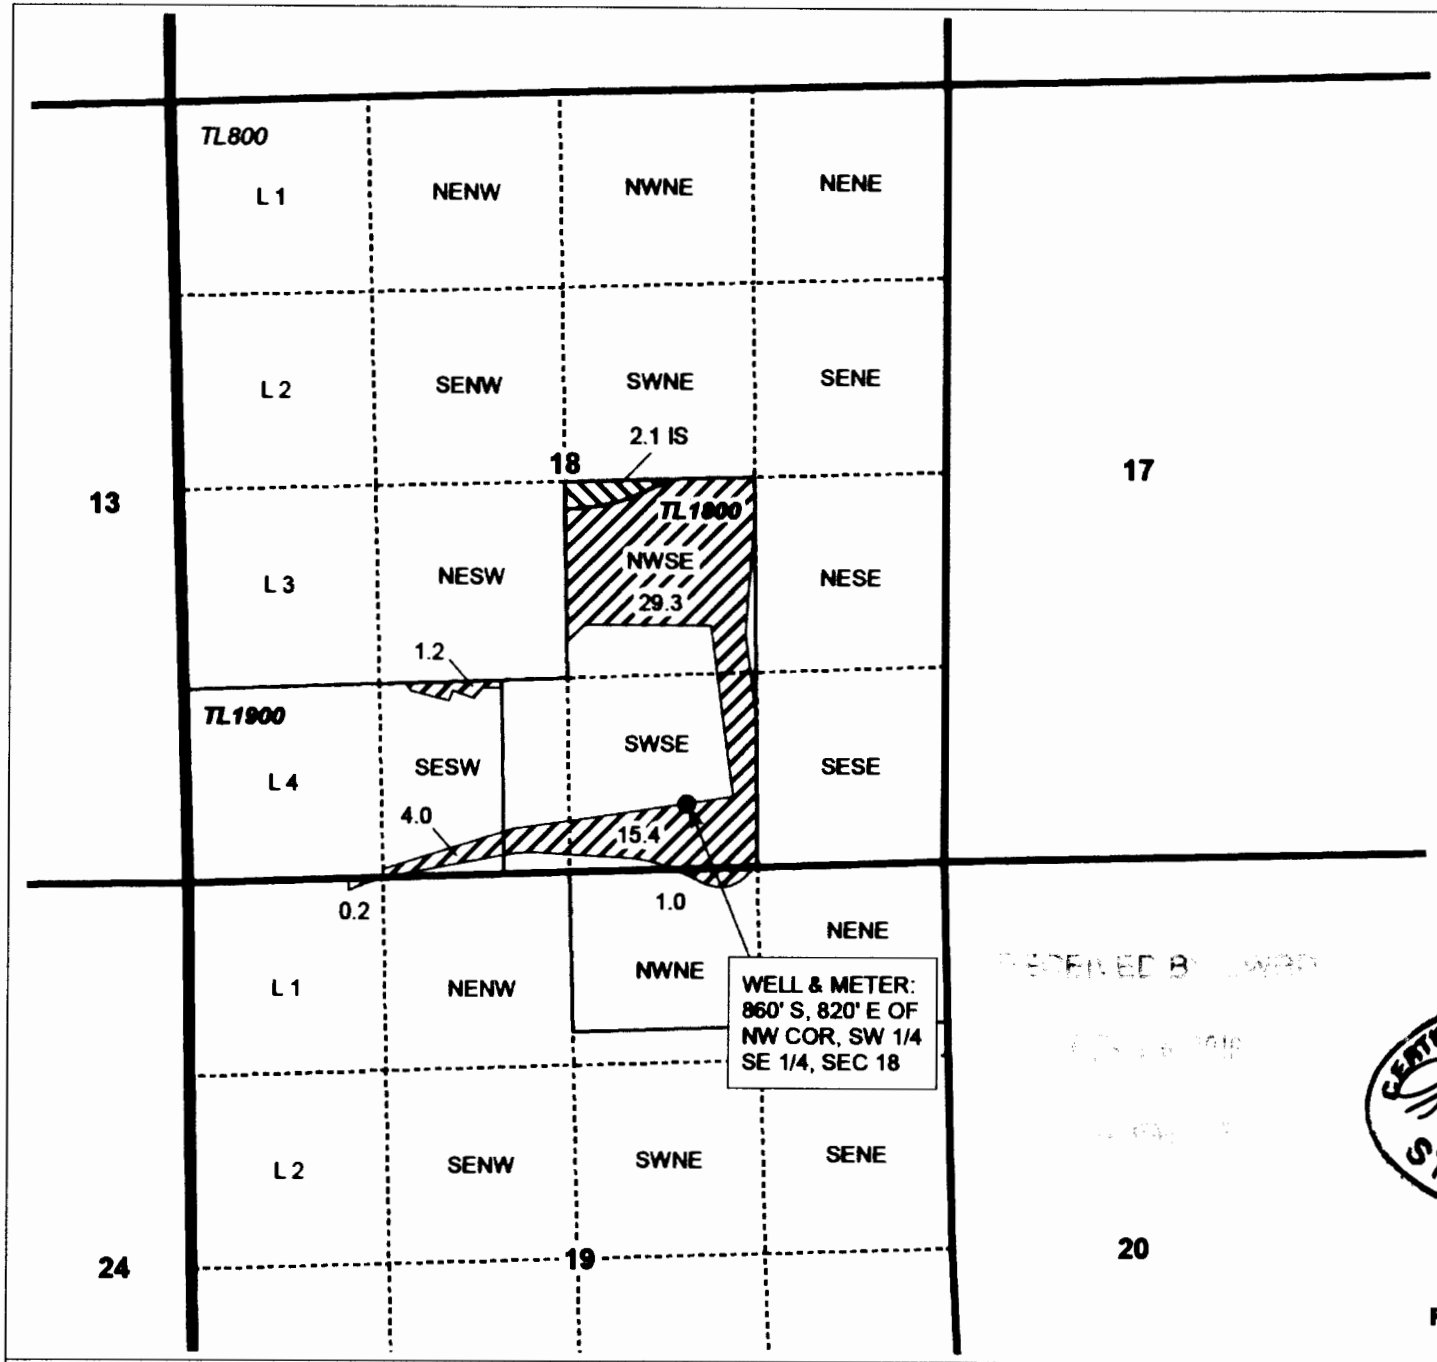

T24S, R30E, SECTIONS 18 AND 19

HARNEY COUNTY, OREGON

0 1,320 Feet

1" = 1,320'

- POU IR
- POU IS
- Township
- Section
- Quarter Quarter
- Tax lot
- Well with meter

CERTIFIED WATER RIGHTS EXAMINER
47708
LINDA LEE MILLER
JUNE 29, 2007
STATE OF OREGON

RENEWAL DATE 12/31/2016

CLAIM OF BENEFICIAL USE

Patti Wilson

AP G-17005 PERMIT G-16400

NOTE: THIS MAP IS NOT INTENDED TO PROVIDE LEGAL DIMENSIONS OR LOCATIONS OF PROPERTY OWNERSHIP LINES.

JANUARY 12, 2016

WATER RIGHT SERVICES, LLC
PO BOX 1830, BEND, OR 97709
CCB# 197121 www.oregonwater.us
541-389-2837 JOHNSHORT@USA.COM