


T.23S.R.32E.W.M.

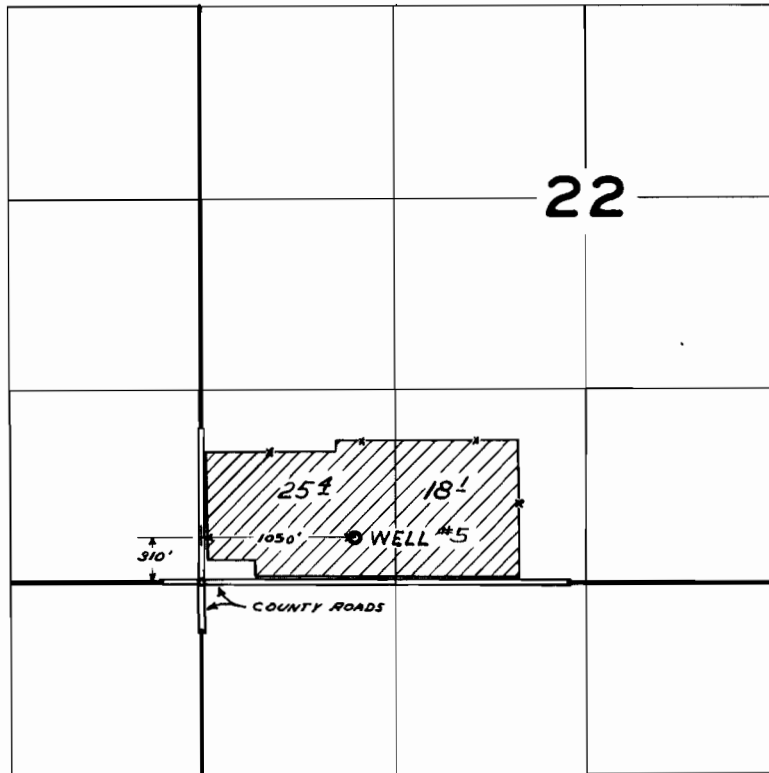

FINAL PROOF SURVEY
UNDER

Application No. G-93 Permit No. G-16
IN NAME OF

T. J. & BESSIE DUHAIME

Surveyed SEP. 16 1963, by C. BAKER