

APPLICATION MAP FOR A CLAIM OF BENEFICIAL USE

PERMIT NUMBER R-80301 R 12870


IN THE NAME OF: COOS BAY NORTH BEND WATERBOARD

PROPERTY LOCATED IN SECTIONS 28,29,32&33 T25S, R13W AND IN SECTIONS 4&5 T26S, R13W

CENTER 1/4  
COR. SEC. 29

WEST 1/4 COR.  
SEC. 28

CENTER 1/4 COR.  
SEC. 28

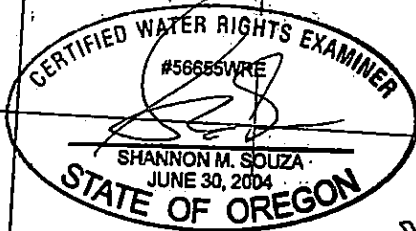

EXPIRATION DATE: 6/30/2014

NORTH 1/4  
COR. SEC. 32

PONY CREEK  
RESERVOIR

DAM LOCATION IS 1989 FEET  
SOUTH AND 503 FEET EAST OF  
THE WEST 1/4 CORNER OF  
SECTION 28 T25S R13W.

SOUTH 1/4 COR.  
SEC. 28

273 ACRES.  
6,250 ACRE FEET

RECEIVED BY WRD

OCT 17 2011

SALEM, OR

CENTER 1/4 COR. SEC. 32

WEST 1/4 COR. SEC. 33

EAST 1/4 COR  
SEC. 32

CENTER 1/4 COR.  
SEC. 33

APPLICANTS:  
COOS BAY NORTH BEND WATERBOARD  
PO BOX 539  
COOS BAY, OR 97420- 0108


PREPARED BY:  
SHANNON SOUZA, CWRE  
SOL COAST CONSULTING & DESIGN LLC  
65431 MILLICOMA RD.  
COOS BAY, OREGON 97420.

- LEGEND:
- FOUND GOVERNMENT CORNER
  - DAM LOCATION

SOUTH 1/4  
COR. SEC. 32

*This map has been updated  
by WRD to reflect Permit  
# R-12870 (Application  
# R-80301). mfb/wrd 3-15-17*

SOUTH 1/4 COR.  
SEC. 33

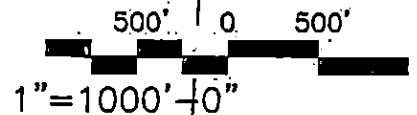

THE PURPOSE OF THIS MAP IS TO IDENTIFY THE  
LOCATION OF THE WATER RIGHT THIS MAP IS NOT  
INTENDED TO PROVIDE LEGAL DIMENSIONS OR  
LOCATIONS OF PROPERTY OWNERSHIP LINES

Sustainable Building / Renewable Energy / Environmental Consulting  
LICENSED, BONDED, & INSURED: CCB# 164208  
65431 Millicoma Ln., Coos Bay, OR 97420  
# 541-266-0877 www.solcoast.com

