


Coley, Ramey, Osborne 48348 Historic POD Transfer Map

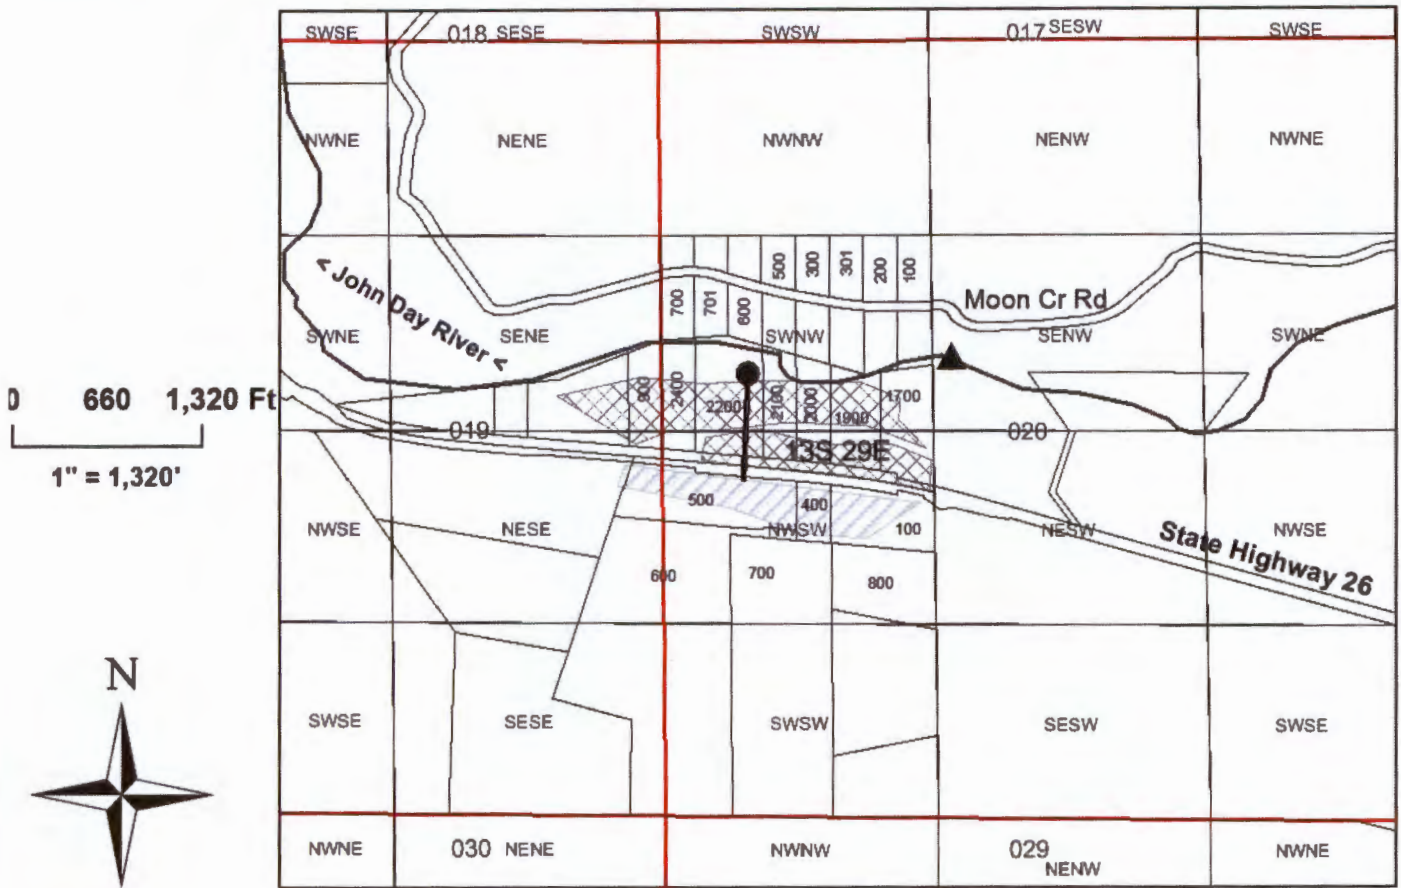

Legend

- Upper Mainstem John Day River
- ▲ Historic POD, 1,414' East, 3,159' North of SW Corner Section 20, 44.426463, -119.260720
- Actual POD, 470' East, 3,127' North of SW Corner Section 20, 44.426139, -119.264537
- Existing Underground Pipe Delivery System
- ▨ Remaining POU
- ▨ Remaining POU
- ▨ Transfer POU, 7.5 Acres

RECEIVED BY OWRD

JUL 11 2016

SALEM, OR

T 12426