






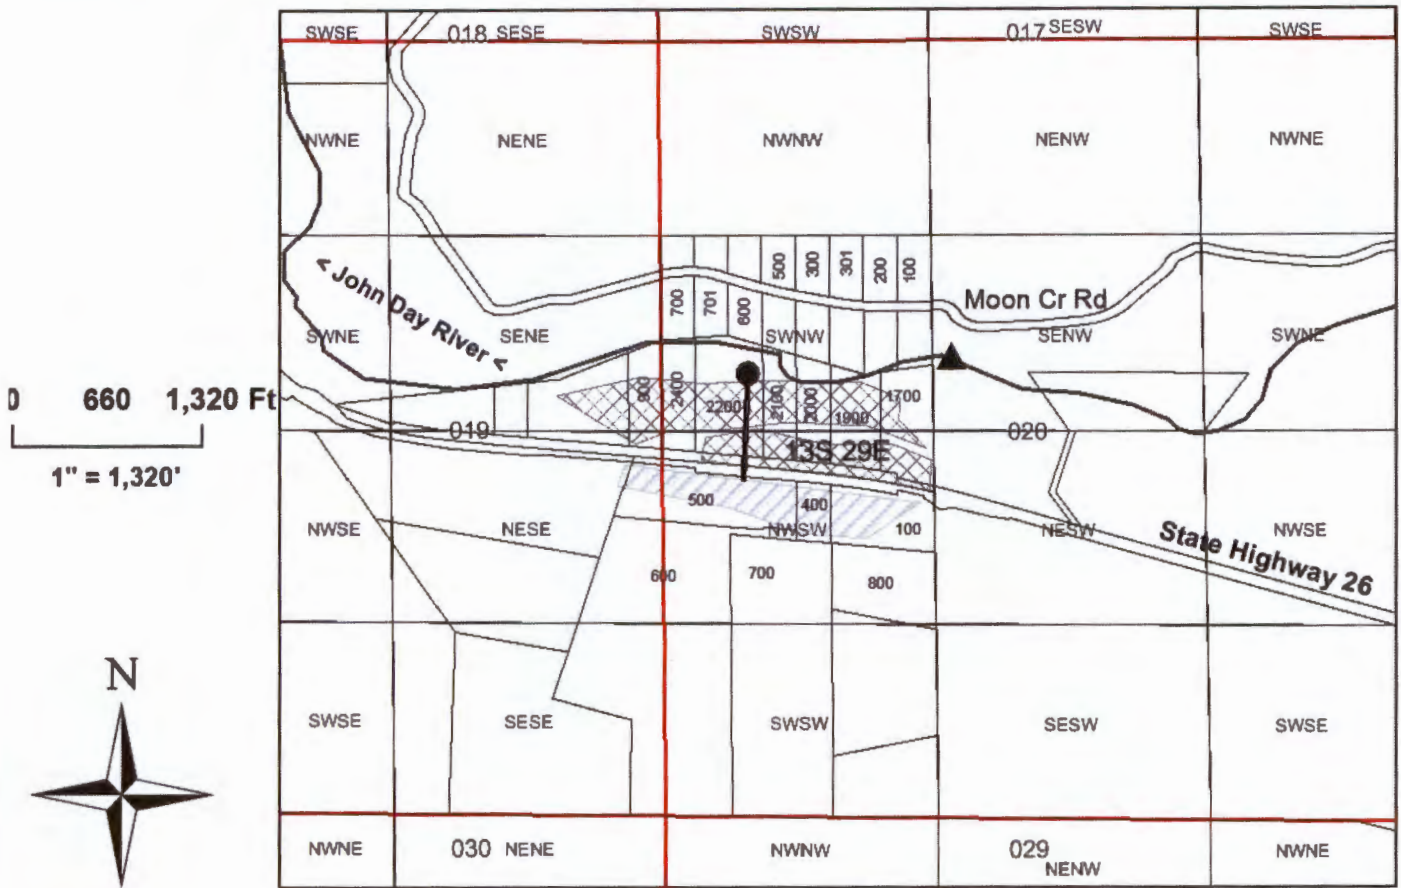


Coley, Ramey, Osborne 48348 Historic POD Transfer Map



Legend

-  Upper Mainstem John Day River
-  Historic POD, 1,414' East, 3,159' North of SW Corner Section 20, 44.426463, -119.260720
-  Actual POD, 470' East, 3,127' North of SW Corner Section 20, 44.426139, -119.264537
-  Existing Underground Pipe Delivery System
-  Remaining POU
-  Remaining POU
-  Transfer POU, 7.5 Acres


RECEIVED BY OWRD

JUL 11 2016

SALEM, OR

T 12426

T.13S. R. 29E.W.M.

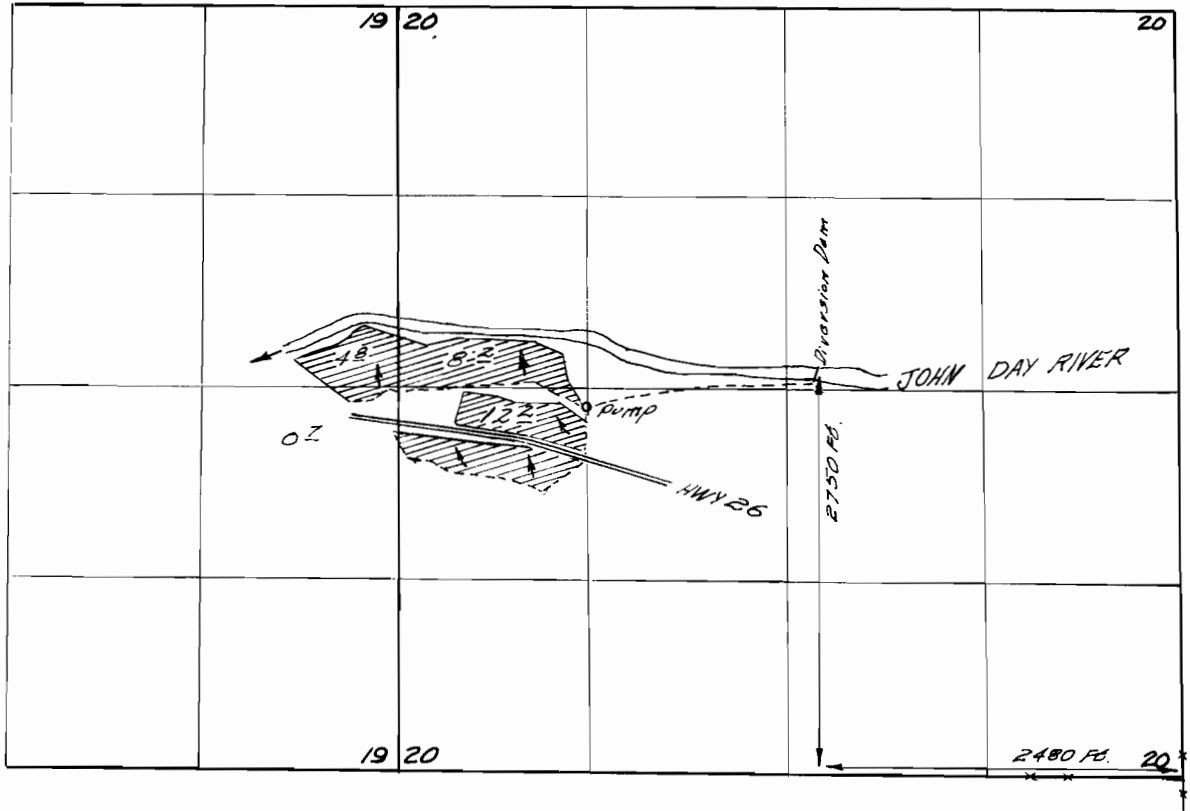

FINAL PROOF SURVEY UNDER

Application No. *38853*. Permit No. *28944*
IN NAME OF

WALLACE F. CAMPBELL

Surveyed *July 18 1968*, by *W. L. Ruppert*