








Map to Accompany Claim of Beneficial Use
For Applications G-13730 & G-16940,
Permits G-12996 & G-16511,
In the Name of Patterson Nursery Sales, Inc.

T.2 S., R.4 E., WM
Section 10

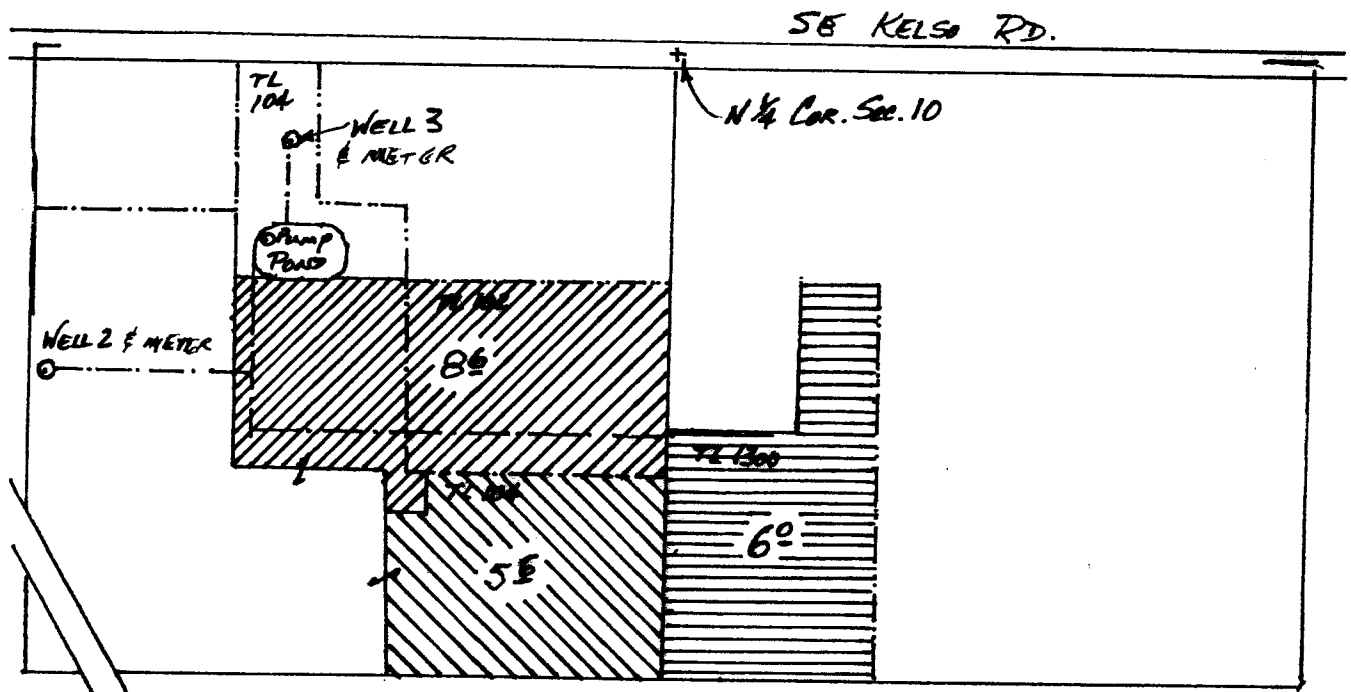

Scale ; 1" = 400'

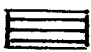-  Permit G-12996
-  Permit G-12996, rate deficiency
-  Permit G-16511

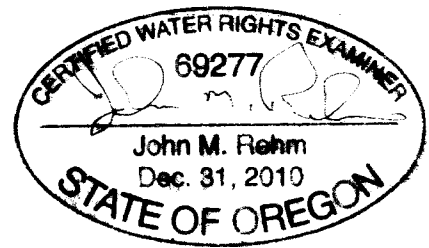

Wells Located: Well 2- 680' S. & 1280' W;
Well 3- 210' S. & 800' W., both from the N1/4 Cor. Section 10.

This map is for the purpose of identifying the location of water rights only, and is not
Intended to provide legal dimensions or locations of property lines.