


Township 4 South, Range 1 West, W.M.
Portions of Sections 5 and 8


RECEIVED

AUG 18 1994

WATER RESOURCES DEP
SALEM, OREGON

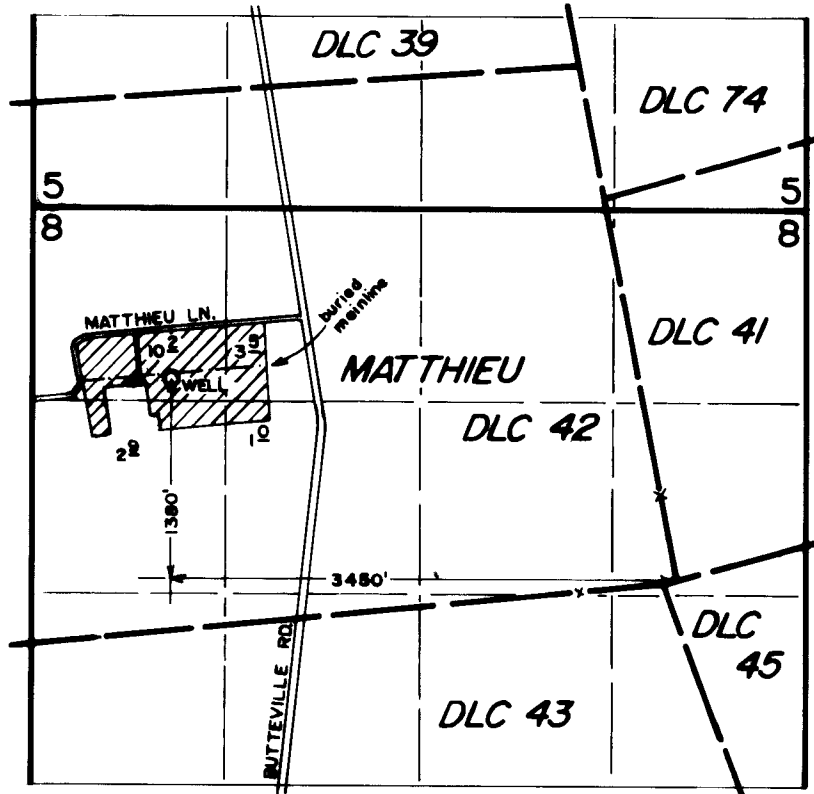

FINAL PROOF SURVEY
under
Appl. No. G-12397, Per. No. G-11402
in name of
BRANT POPMA
August 9, 1994

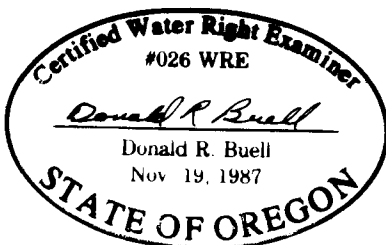

THIS MAP WAS PREPARED FOR THE PURPOSE OF IDENTIFYING THE LOCATION OF A WATER RIGHT ONLY AND IS NOT INTENDED TO PROVIDE LEGAL DIMENSIONS OR LOCATION OF PROPERTY OWNERSHIP LINES.