

CLAIM OF BENEFICIAL USE MAP


FOR: HELEN E. NORTHCRAFT TRUST

BY: NATHAN R. REED, CWRE

T29S, R7W, W.M. SECTION 4 DLC 41


APPLICATION NO. S-87580

PERMIT NO. S-54713

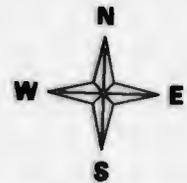

SCALE: 1" = 1320'

DATE SURVEYED: JUNE 12, 2012

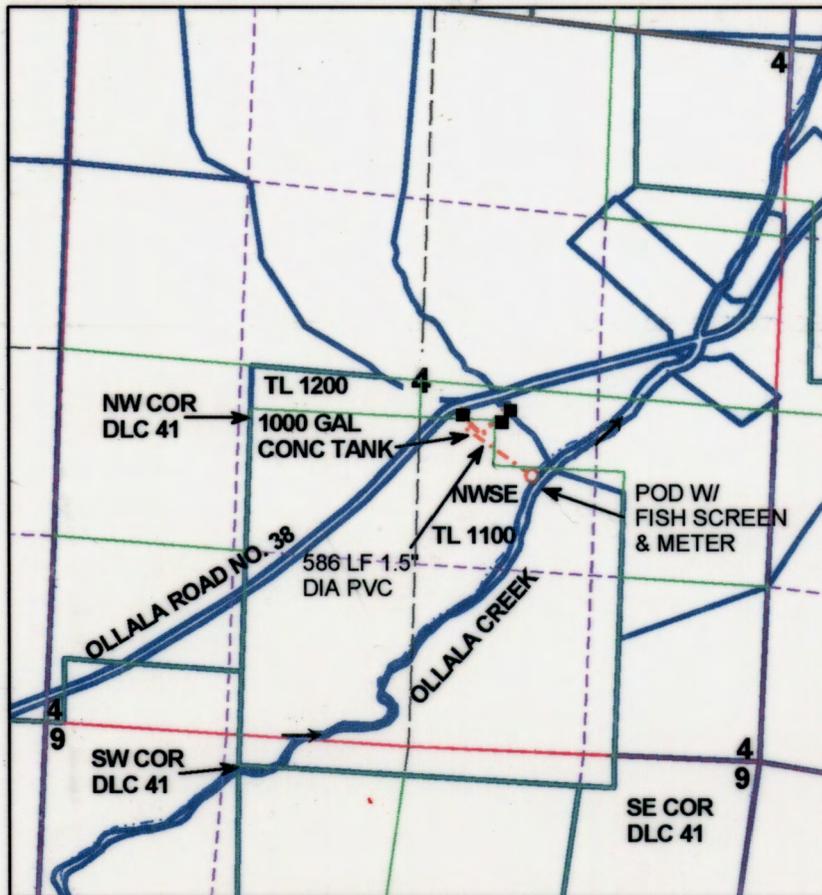


Legend

- structure
- POD
- Pipeline
- - - Stream
- Flow_arrow
- Township
- DLC
- Section
- Quarter
- Sixteenth
- Parcels

POD IS LOCATED 804 FEET EAST AND 726 FEET SOUTH OF THE CENTER CORNER OF SECTION 4.

IRRIGATION AREAS LIMITED TO LAWN(S) AND/OR GARDEN(S) AROUND THE HOUSES AT 0.5 ACRES EACH.

MAP PREPARED FOR:
HELEN E. NORTHCRAFT TRUST
3791 OLLALA ROAD
WINSTON, OR 97406

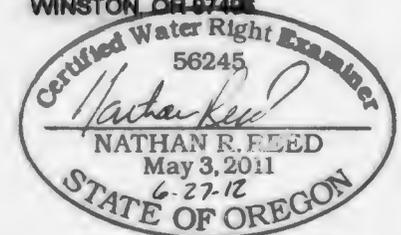

Expires Dec. 31, 2012

RECEIVED

JUL 02 2012

WATER RESOURCES DEPT
SALEM, OREGON

THE PURPOSE OF THIS MAP IS TO IDENTIFY THE LOCATION OF THE WATER RIGHT. IT IS NOT INTENDED TO PROVIDE INFORMATION RELATIVE TO THE LOCATION OF PROPERTY OWNERSHIP BOUNDARY LINES.

MAP PREPARED BY:
NATHAN R. REED, P.E., CWRE
1113 SE CASS AV
ROSEBURG, OR 97470