


Claim of Beneficial Use for
Bonnie Philippart
In Govt. Lot 3, Section 9
T. 37 s., R. 14 W., w. m.
Curry County, Oregon
Application #S-73317 Permit #S-52237

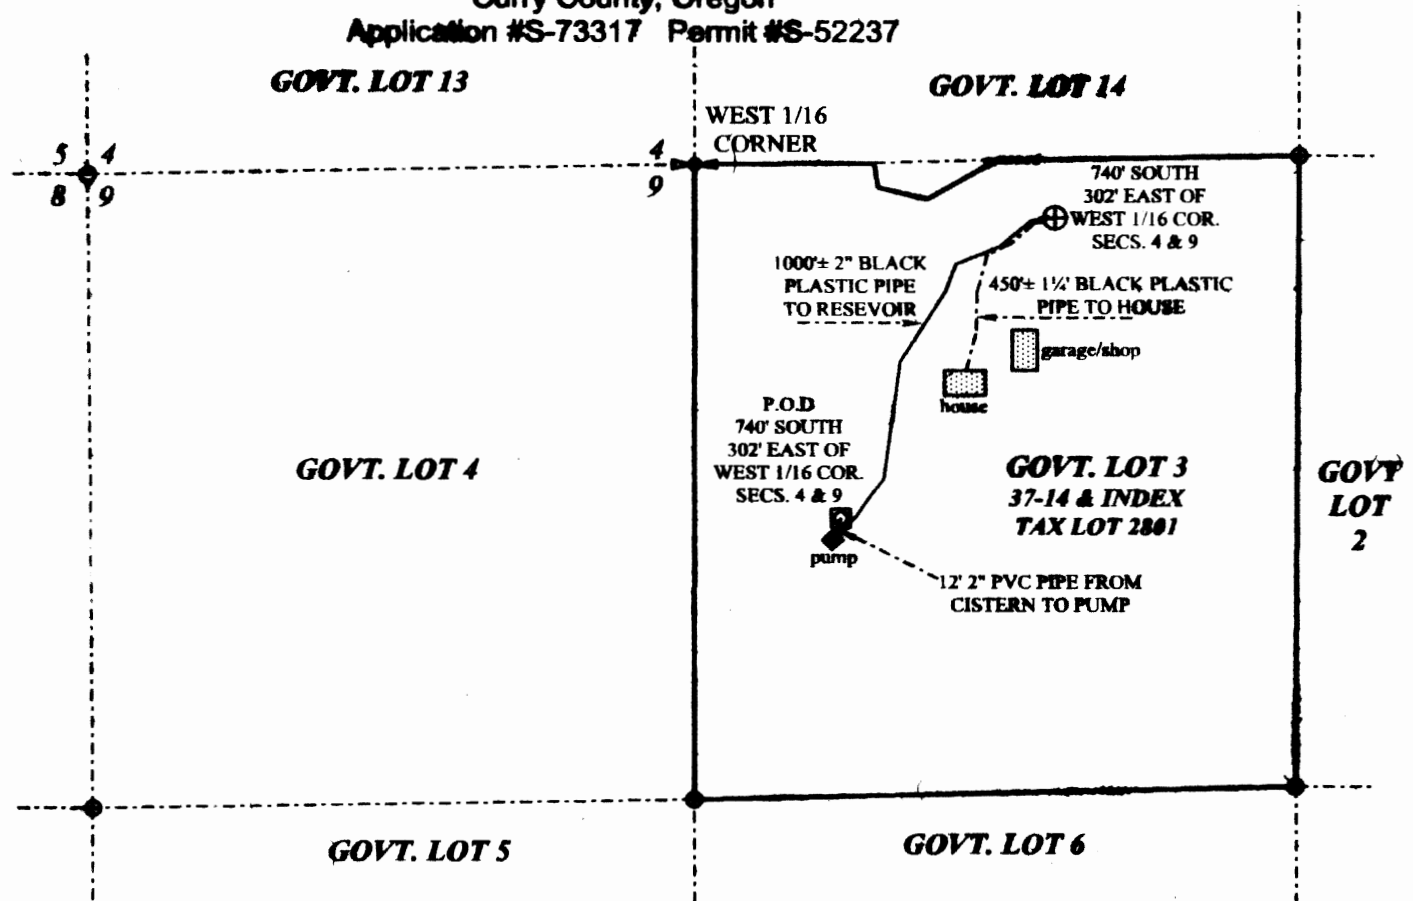

**THIS MAP IS NOT INTENDED TO PROVIDE LEGAL
DIMENSIONS OR LOCATION OF PROPERTY OWNERSHIP LINES.**

LEGEND

- WEST 1/16 CORNER, SECS. 4 & 9, POINT
OF LATITUDE & DEPARTURE FOR POD
AND THE 2500 GALLON RESEVOIR TANK
- POINT OF DIVERSION
3' DIAMETER CONCRETE CISTERN
- ◆ GHP GASOLINE POWERED PUMP MOUNTED ON
CONCRETE 529'W, 12' FROM POD
- ⊕ 2500 GALLON PLASTIC RESEVOIR TANK

RECEIVED BY OWRD

OCT 11 2012

SALEM, OR

**1" = 400'
APRIL 2012**



FLAVIN LAND SURVEYING
32053 CEDAR VALLEY ROAD
GOLD BEACH, OREGON 97444

RENEWED THROUGH 12/31/13