

CLAIM OF BENEFICIAL USE

LOCATED IN THE NW $\frac{1}{4}$ OF THE NE $\frac{1}{4}$ OF THE SE $\frac{1}{4}$, SECTION 3,
T.41S., R.13W., W.M., CURRY COUNTY, OREGON

TL 41-13-03 0700


PREPARED FOR: GRETCHEN HURLEY

APPLICATION: S-71528

PREPARED BY: STUNTZNER ENG. &
FORESTRY, COOS BAY, OREGON

PERMIT: S-52238

DATE: MAR. 19, 2012

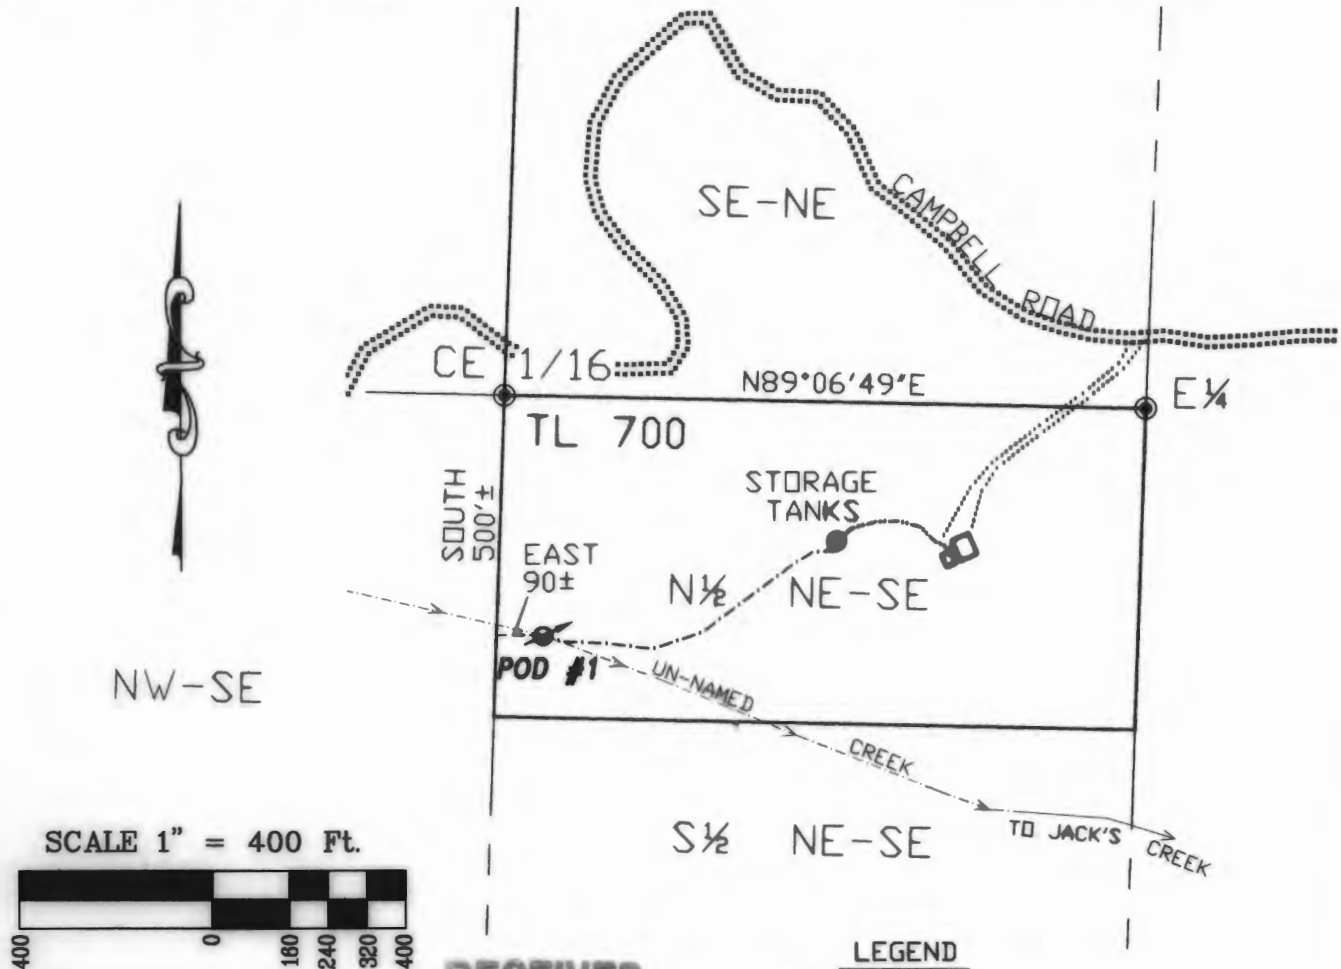

RECEIVED

MAR 27 2012

WATER RESOURCES DEPT
SALEM, OREGON



EXPIRES 06/30/2013

THE PREPARATION OF THIS MAP WAS FOR THE
PURPOSE OF IDENTIFYING THE LOCATION OF
THE WATER RIGHT ONLY AND HAS NO INTENT
TO PROVIDE DIMENSIONS OR LOCATION OF
PROPERTY OWNERSHIP.

Stuntzner
Engineering
& Forestry, LLC

706 S. 4TH ST.
P.O. BOX 118
COOS BAY, OREGON 97420

PHONE: (541) 267-2872
FAX: (541) 267-0588
www.stuntzner.com

Engineering - Land Surveying - Forestry - Land Planning - Water Rights

JOB #: 12-3-030

DATE: Mar. 19, 2012

DRAWN BY: ELS

CHECKED BY: TMH

PREPARED

FOR:

Gretchen Hurley

16352 Campbell RD.

Brookings, OR 97415

FILE NAME: Survey Block Title.dwg

SHEET 1 OF 1