


SEC.31 T.30S. R.5W. W.M.  
DOUGLAS COUNTY  
Scale 1" = 1000'

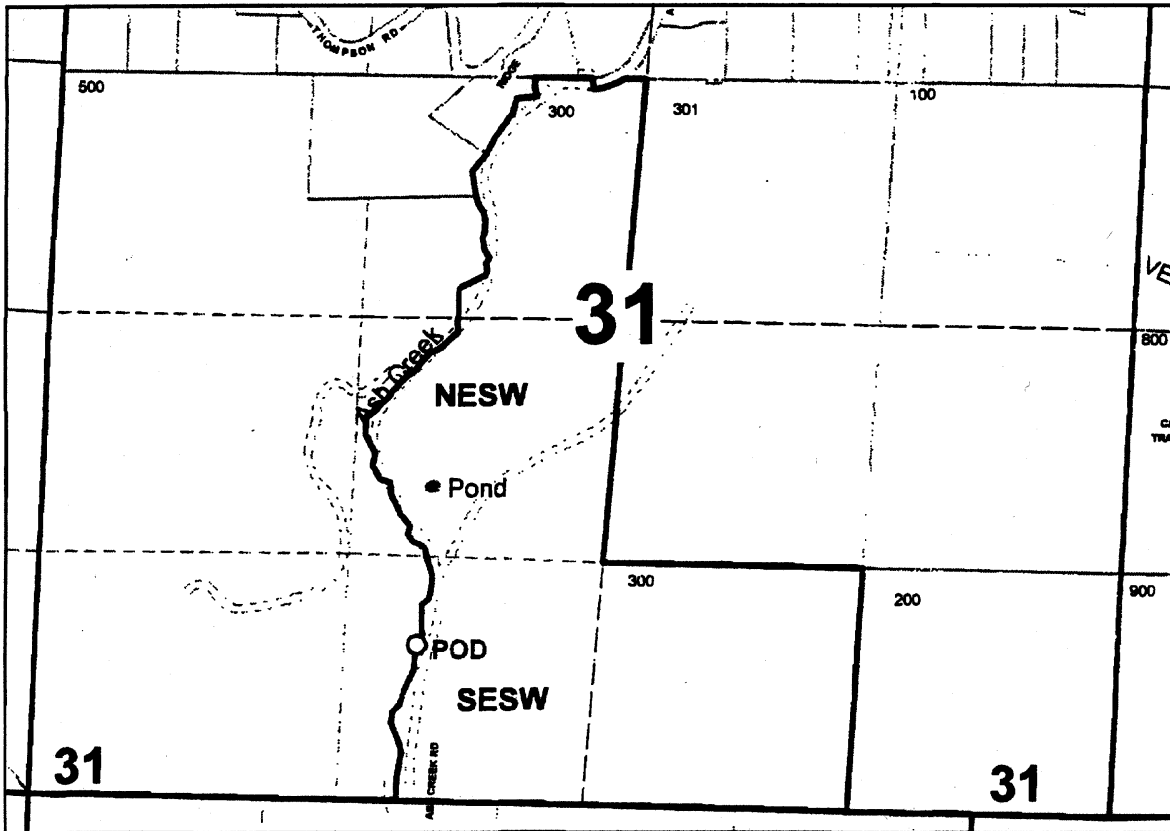

Pond is 2200 ft. S. and 2300 ft. W. from the NE 1/16 corner of section 31.  
POD is 3155 ft. S. and 2333 ft. W. from the NE 1/16 corner of section 31.

RECEIVED

JAN 26 2010

RECEIVED BY OWRD  
WATER RESOURCES DEPT  
SALEM, OREGON

DEC 02 2016

SALEM, OR

Application R-87572