


T39S, R35E, Sections 23 and 26, W.M.

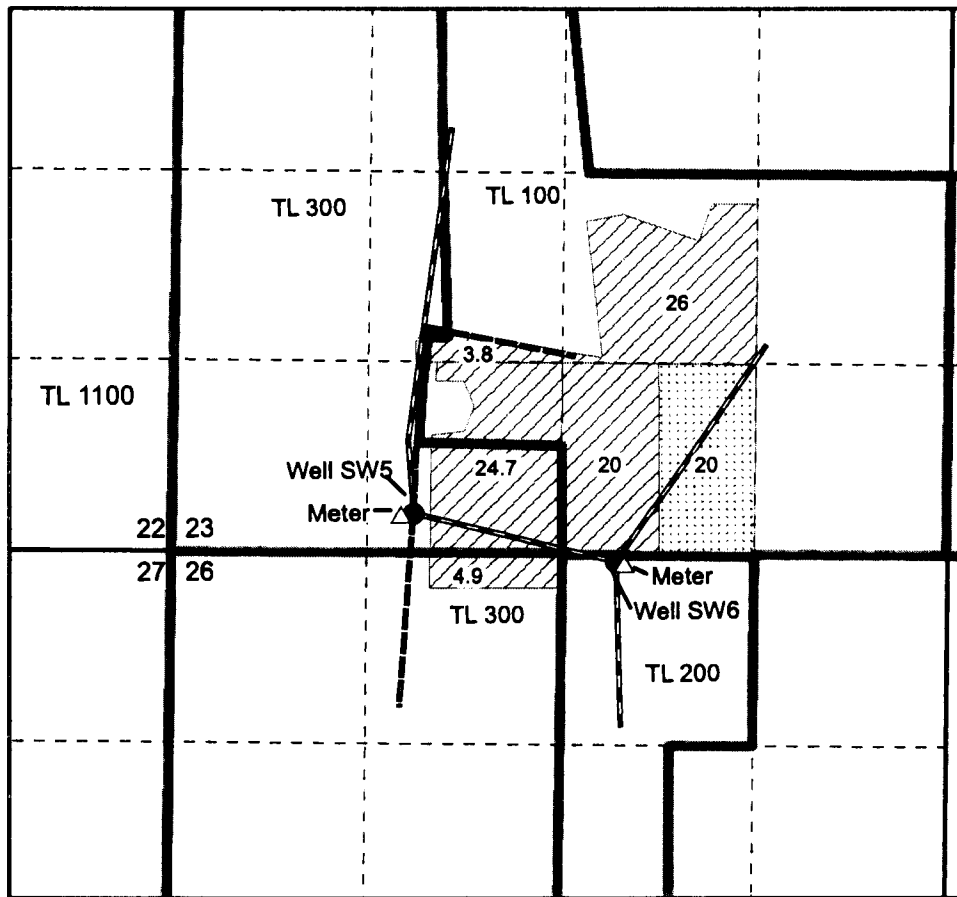


- △ Meter
- Wells
- 8 inch laterals
- Mainline
- Section line
- - - Quarter quarter line
- Tax lot line
- ▨ T11700 Supplemental (Priority 1955)
- ▩ T11700 Primary (Priority 1955)

Well SW5 (HARN 1804) is located 280 feet north and 1620 feet east of the SW corner of section 23

Well SW6 (HARN 1798) is located 3530 feet east and 100 feet south of the northwest corner of section 26,

This map is not intended to provide legal dimensions or locations of property ownership lines.

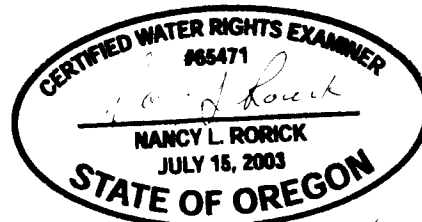

Expires 12/31/2016

Final Proof Map for T11700
 Tax Lots 100, 200, 300
 Pueblo Mountain Land Company, LLC
 prepared by Nancy Rorick Consulting

