


741

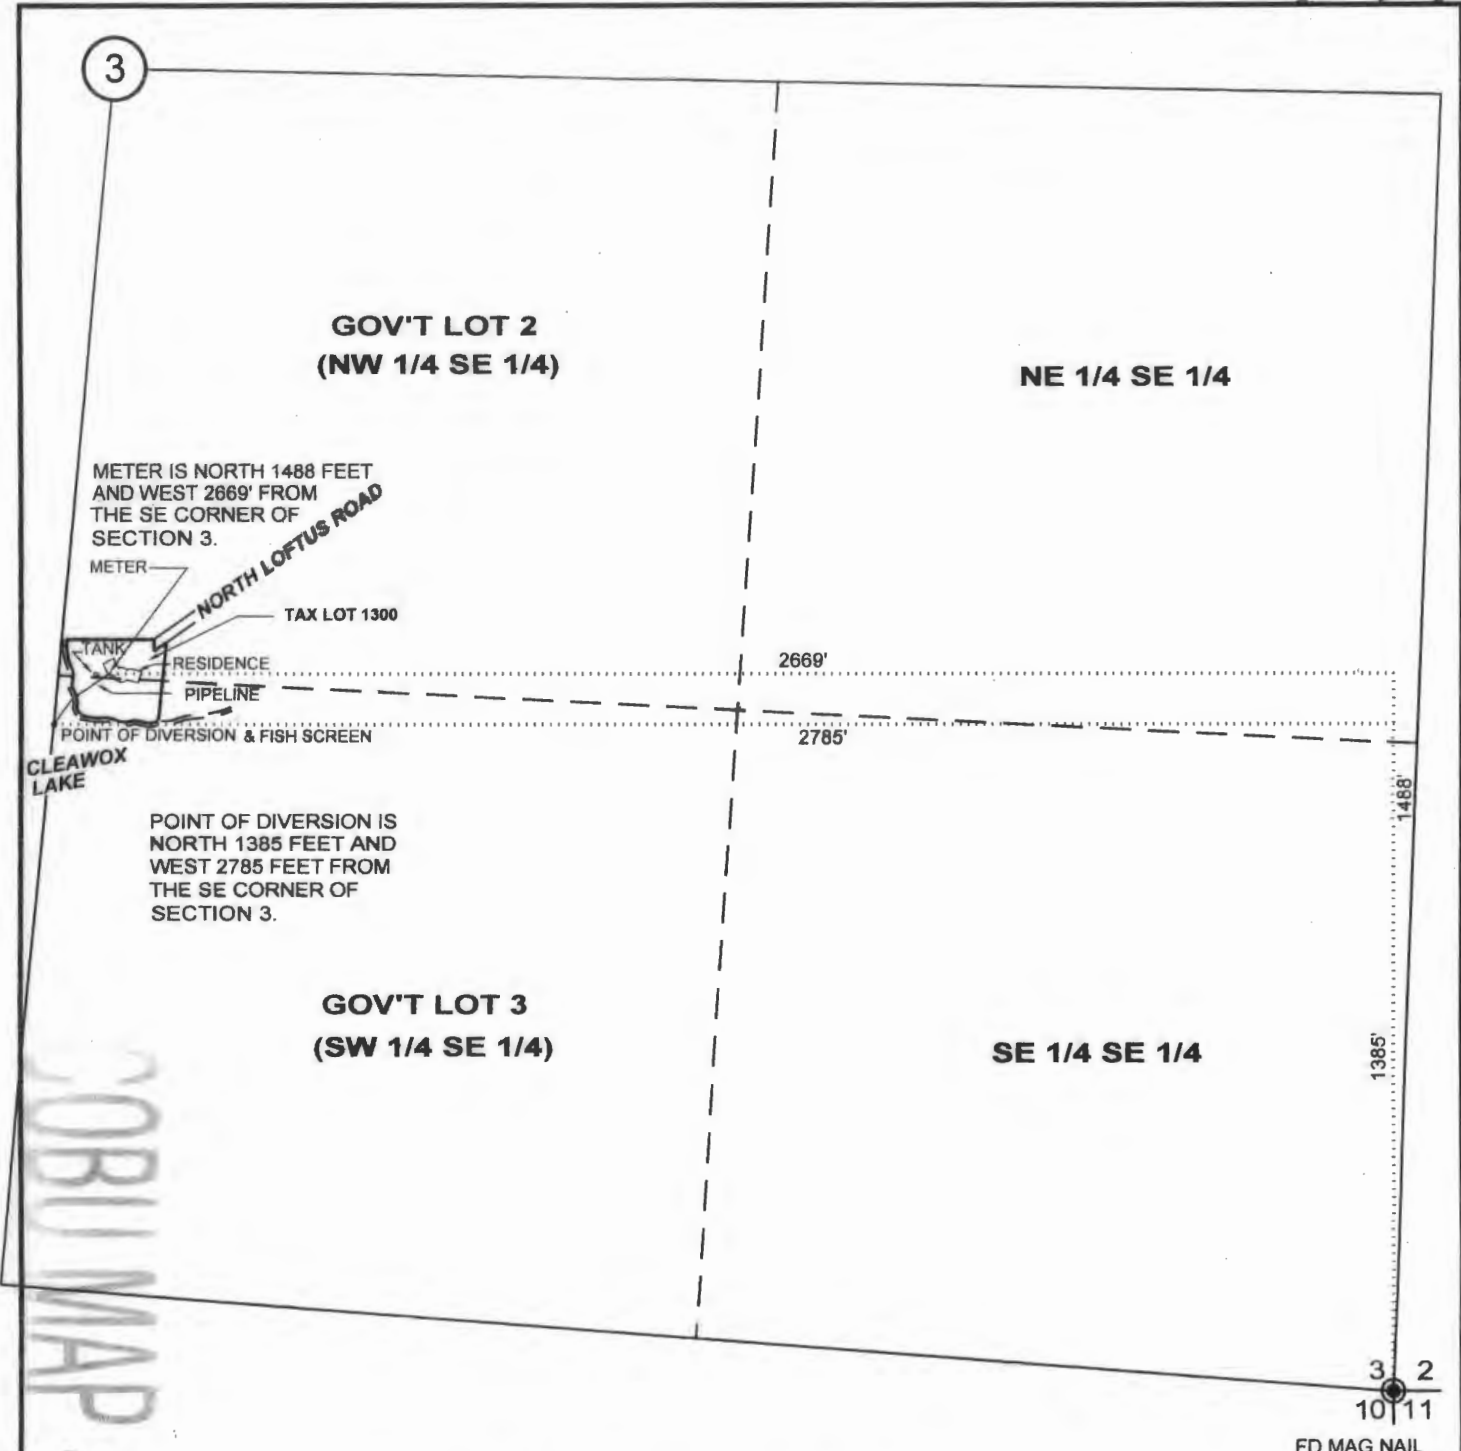

JOB MAP # 741 file S

CLAIM OF BENEFICIAL USE WATER RIGHTS MAP

MID COAST BASIN
UNDER APPLICATION S-87560
UNDER PERMIT S-54656

NW 1/4, SE 1/4, SEC 3, T19S, R12W, W.M.
SW 1/4, SE 1/4, SEC 3, T19S, R12W, W.M.
19-12-03-4, T.L. 1300
LANE COUNTY, OREGON

RECEIVED BY OWRD

FOR: DONALD S. McCALL
4851 NORTH LOFTUS ROAD
FLORENCE, OREGON 97439

JAN 08 2013

SALEM, OR

PREPARED BY: WOBBE & ASSOCIATES, INC.
510 KINGWOOD ST. / P.O. BOX 3093
FLORENCE, OR 97439
DATE: DECEMBER 27, 2012

THIS MAP IS FOR THE PURPOSE
OF IDENTIFYING THE LOCATION
OF THE WATER RIGHT ONLY.
THERE IS NO INTENT TO PROVIDE
DIMENSIONS OR LOCATION OF
PROPERTY OWNERSHIP LINES.

