

CLAIM OF BENEFICIAL USE MAP


APPLICATION S-75215 PERMIT S-53596
IRRIGATION

FOR

ES PROPERTY HOLDINGS, LLC
7159 CROWFOOT ROAD
TRAIL, OREGON 97541


SITUATED IN

SECTION 32, TOWNSHIP 33 SOUTH, RANGE 1 EAST, W.M.
JACKSON COUNTY, OREGON

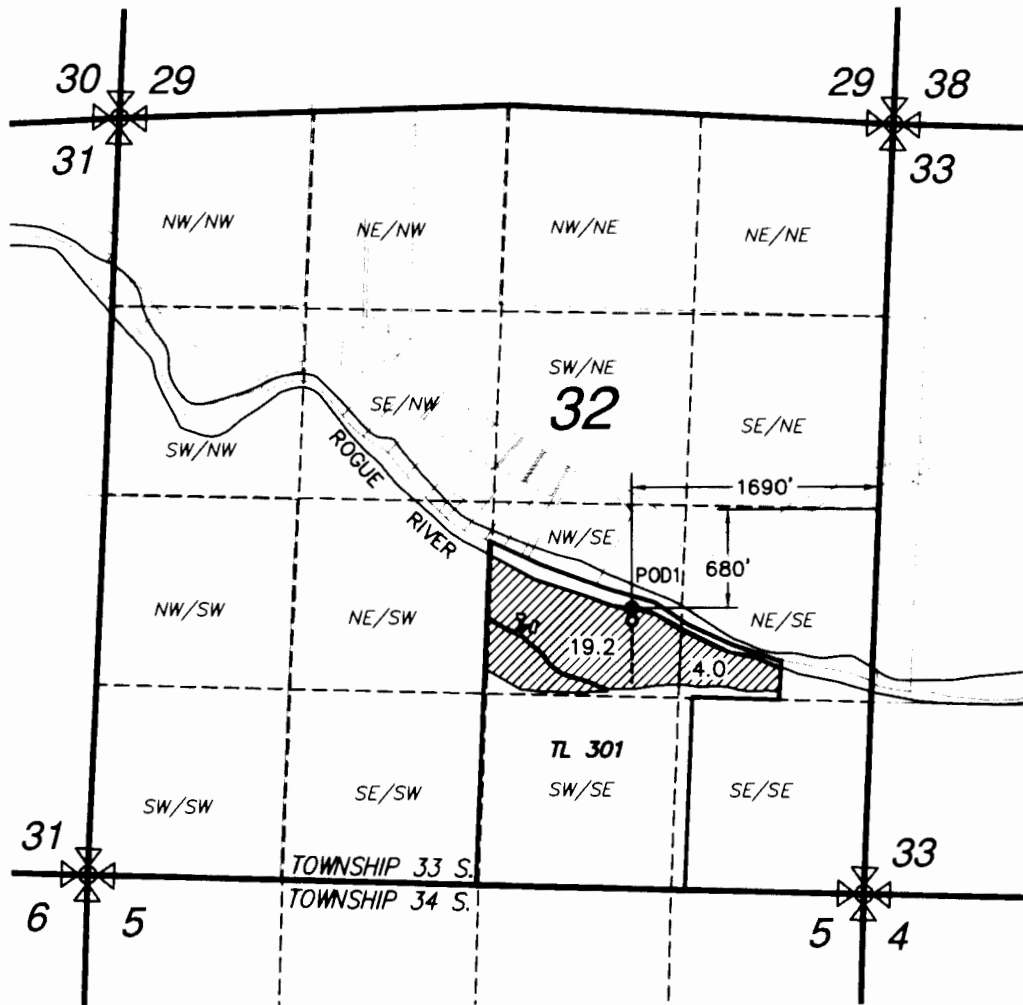

LEGEND

- POINT OF DIVERSION AND FISH SCREEN
- ⊙ PUMP AND METER
- 1/4-1/4 SECTION LINE
- BURIED MAINLINE
- ▨ PLACE OF USE

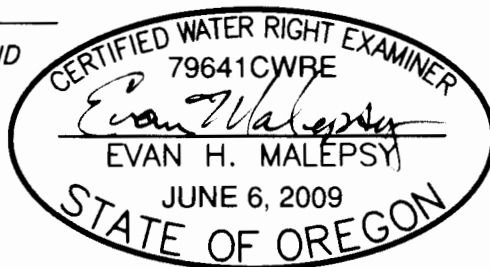

This map is not intended to provide legal dimensions or locations of property ownership lines.

RENEWS: 12/31/2018

EHM-August 23, 2012
Revised April 5, 2017 - EHM