


T.11S., R.21E.

24 19 Fd. Brass
25 30 Cap Mon.

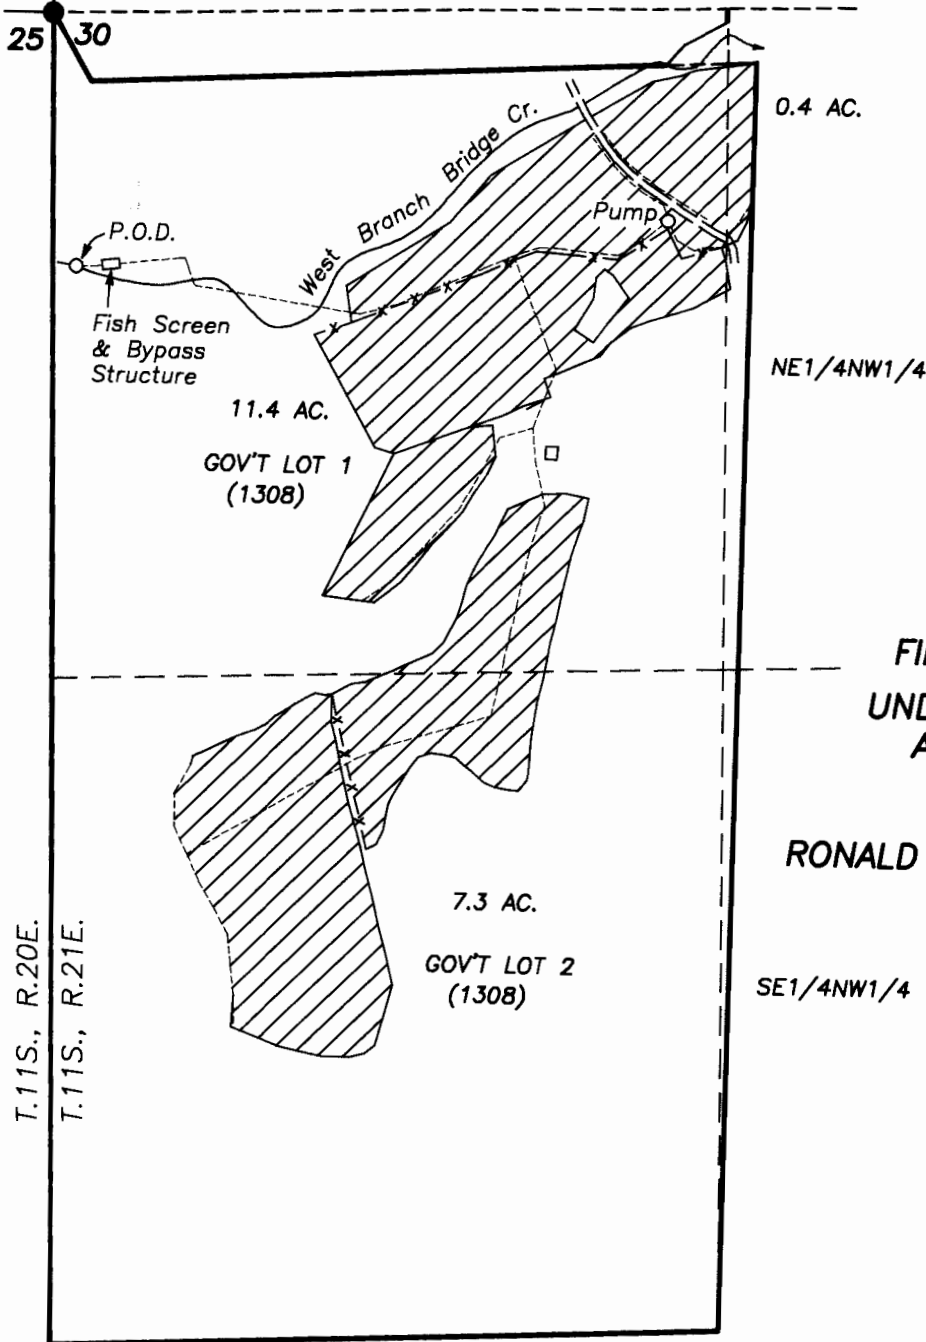

SCALE: 1" = 400'

**FINAL PROOF SURVEY
UNDER PERMIT S-47549
APPLICATION S-64834**

IN NAME OF
RONALD Q. AND DONNA S. DAVIS

BY
ROBERT D. BAGETT
217 N. CANYON BLVD.
JOHN DAY, OREGON
(541) 575-1251

**SURVEY COMPLETED
AUGUST 26, 2011**

POD IS 530 FT. SOUTH AND 60 FT. EAST OF THE NW CORNER OF SEC. 30, T.11S., R.21E., W.M. FISH SCREEN AND BYPASS STRUCTURE IS N87°E 70 FT. FROM P.O.D.

PLACE OF USE

----- BURIED MAIN LINE

-x-x- FENCE LINE

() TAX LOT NO.

NOTE: THE PREPARATION OF THIS MAP WAS FOR THE PURPOSE OF IDENTIFYING THE LOCATION OF THE PROPOSED WATER RIGHT AND HAS NO INTENT TO PROVIDE DIMENSIONS OR LOCATION OF PROPERTY OWNERSHIP LINES.

RECEIVED

SEP 20 2011

**WATER RESOURCES DEPT
SALEM, OREGON**

