
T. 29 S., R. 3 W., W.M.

SCALE: 1" = 400'

THIS MAP IS NOT INTENDED TO PROVIDE LEGAL DIMENSIONS OR LOCATIONS OF PROPERTY OWNERSHIP.

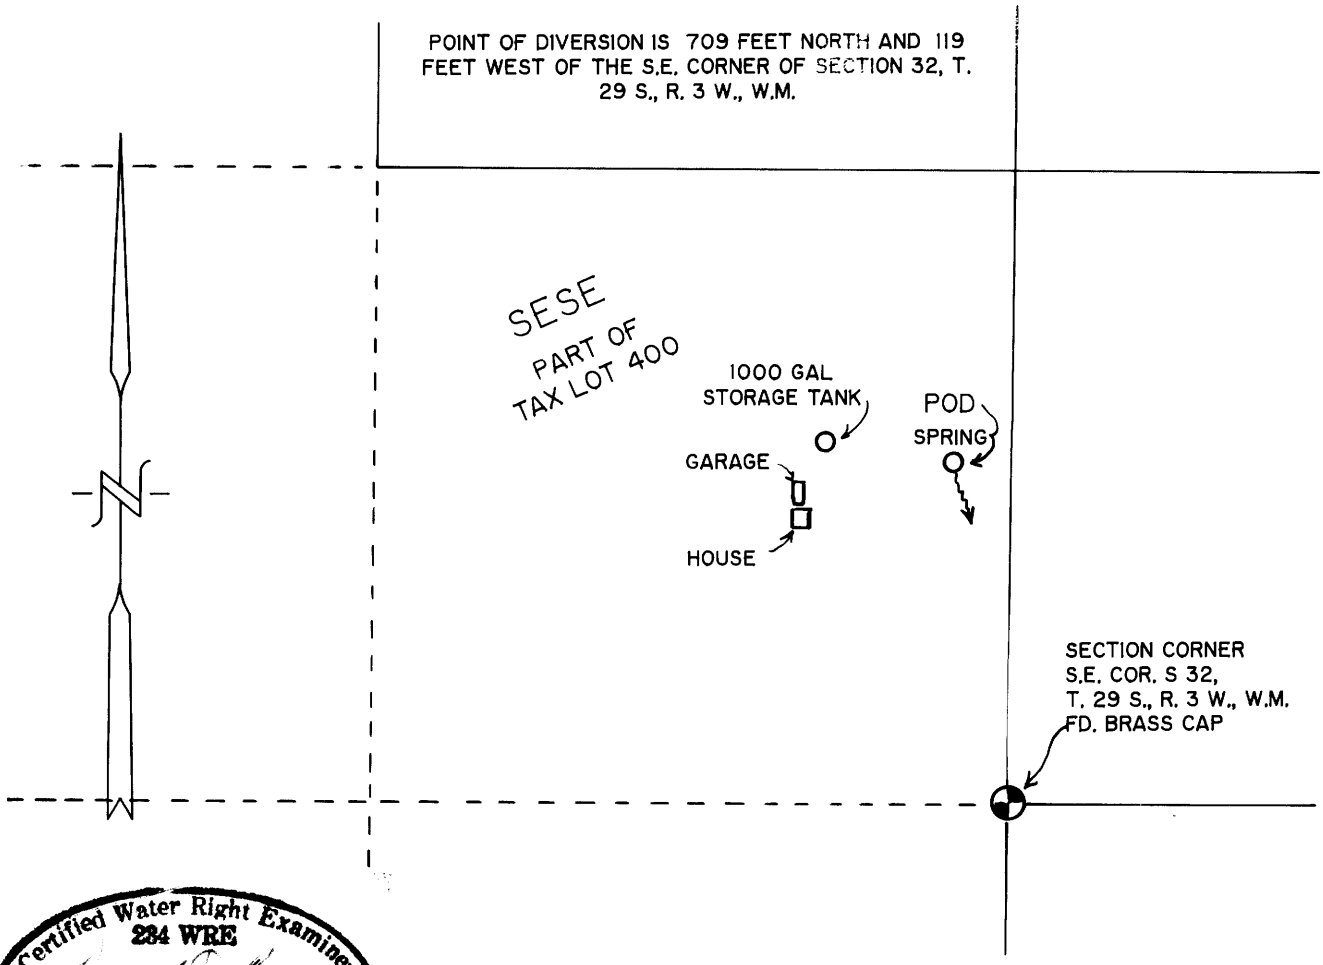

Certified Water Right Examiner
234 WRE
Raymond F. Brown
May 22, 1990
STATE OF OREGON

EXP. 12/31/2013

FINAL PROOF SURVEY

UNDER

Application No. S-72028, Permit No. 52624

IN NAME OF

KAREN L. SHARP

Surveyed APR. 18, 2012 by: R.F. BROWN