


WELL LOCATED 13.32' SOUTH AND 3957.22' WEST OF THE NORTHEAST CORNER OF SECTION 33 FLOWMETER IS LOCATED 4.62' FROM WELL

CLAIM OF BENEFICIAL USE MAP

FOR
LYNN R. POPE


SECTIONS 28, 29 & 33
TOWNSHIP 40 SOUTH RANGE 11 EAST, W.M.
KLAMATH COUNTY, OREGON

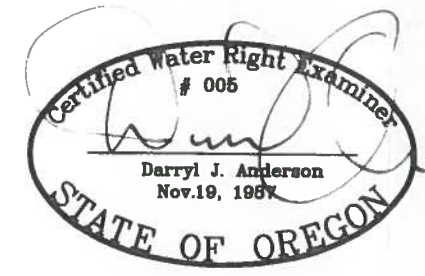

RENEWAL 12/31/09

RECEIVED
APR 24 2008
WATER RESOURCES DEPT
SALEM OREGON

- LEGEND**
- SECTION LINE
 - 1/4 SECTION LINE
 - 1/16 SECTION LINE
 - IRRIGATION MAIN LINE
 - SUPPLEMENTAL IRRIGATION

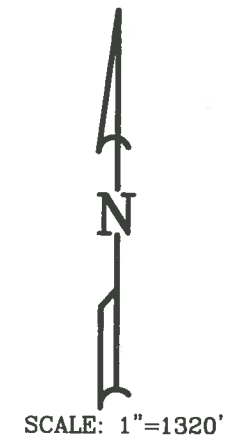

APPLICATION NO. G-12811
PERMIT NO. G-12431

NOTE:
PREPARATION OF THIS MAP IS FOR IDENTIFYING PROPOSED WATER RIGHTS ONLY. IT HAS NO INTENT TO PROVIDE LOCATIONS OR DIMENSIONS OF PROPERTY BOUNDARIES.

REVISION	BY

ANDERSON ENGINEERING AND SURVEYING, INC.
P.O. BOX 28
LAKEVIEW, OREGON 97630
(541) 947-4407
FAX: 947-2321

FOR:
LYNN R. POPE
21860 POPE ROAD
MERRILL, OR 97633
(541) 798-5638

CLAIM OF BENEFICIAL USE
APPLICATION NO. G-12811
PERMIT NO. G-12431

DATE:	11-14-07
SCALE:	1"=1320'
DWG. BY:	R.C.
JOB:	2007-171
FILE:	2007-171
SHEET:	1 OF 1

COBU MAP # 0341