


T23S, R28E, W.M.
Harney County, Oregon

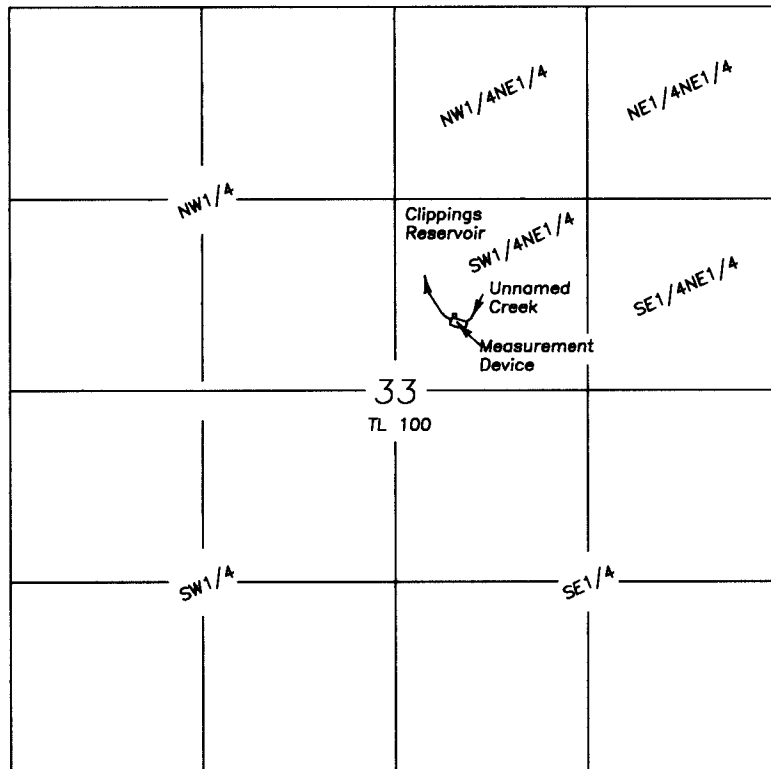

SCALE 1"=1320'

Outlet is located 2140' S & 3050' E of the
NW corner of Section 33.
Measuring device is located 5' West of the Outlet

FINAL PROOF SURVEY
CLAIM OF BENEFICIAL USE
CLIPPINGS RESERVOIR

LEGEND

Application No. R-39030
Permit No. R-7620
Priority 8/26/1963

A portion of Tax Lot
23-28 TL100

NOTE: Tax Lot 100 is owned by the BLM
and is more that 22,000 acres.
No tax lot boundaries can be shown.

For

Bureau of Land Managment
September 9, 2016

Prepared by

Cornerstone Surveying, Inc
P.O. BOX 33
JOHN DAY, OR. 97845
(541)575-1813
cornerstonesurvey@centurytel.net

RECEIVED BY OWRD

NOTE: The preparation of this map
was for the purpose of identifying
the location of the proposed water
right and has no intent to provide
dimensions or location of property
ownership lines.

NOV 14 2016

SALEM, OR

